

#92

DRAIN

Park St.

e.s.

n of Arnold St.

Permit

No. 16950-56

Enters

Park St. Sewer

Drain Plot No.

From Property of


Russell S. Tripp

Reconnected - "West End
Sewer Separation Project"

CDM v

AS Built 09/1999

See Case B

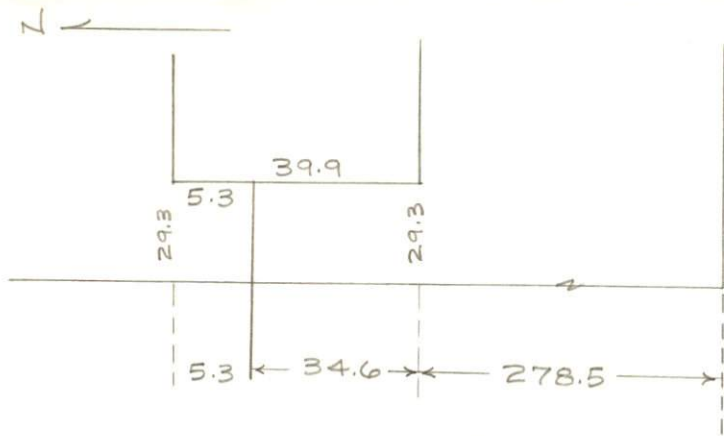

Park St.

Arnold St.