

DRAIN

(#12 Ash St.)

Bedford St. N.S.

East of Ash St.

Permit
No. #17393-58.....

Enters Bedford St. Sewer
Drain Plot No.

From Property of Mrs. Bernadette Hemingway

Reconnected - West End


CDMW

Sewer Separation Project "

As Built 09/1999

See Case B

Ash St.

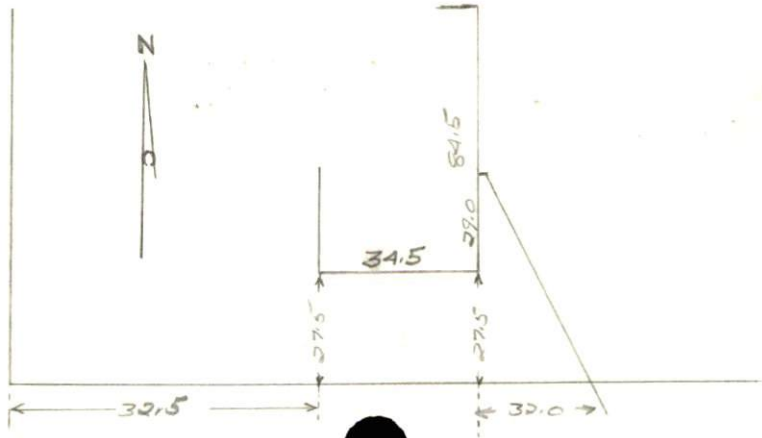

Bedford St.