

DRAIN

Permit

No. 20693-82

BAITLIETT ST.

N.W. COR. BRISTOL ST.

Enters

BAITLIETT ST. SEWER & ST. DRAIN


Drain Plot No.

185

From Property of

BAITLIETT HTS. (DORO DEV. CORP.)

BRISTOL ST.

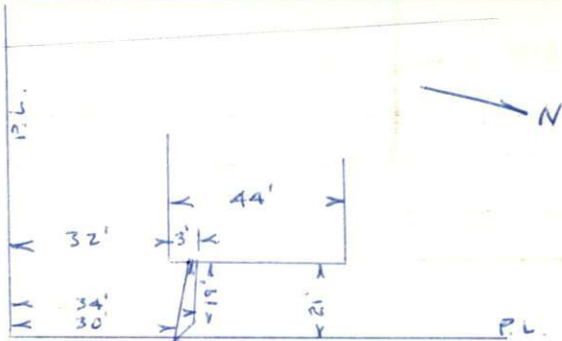

BARTLETT ST.

4" S.O.

6" S.

ALL DIMENSIONS SCALED FROM "AS-BUILT"
RECORD PLAN, ARE THEREFORE ±