

DRAIN

CHURCH ST. E.S.

Permit

BTWN. PARK AVE. & TARKILN HILL RD.

No.

20715-83

Enters

CHURCH ST. SEWER & ST. DR.


Drain Plot No.

164

From Property of

FAIRHAVEN SAVINGS BANK

SEE 13748-25
FOR EXIST. STUB LOC.

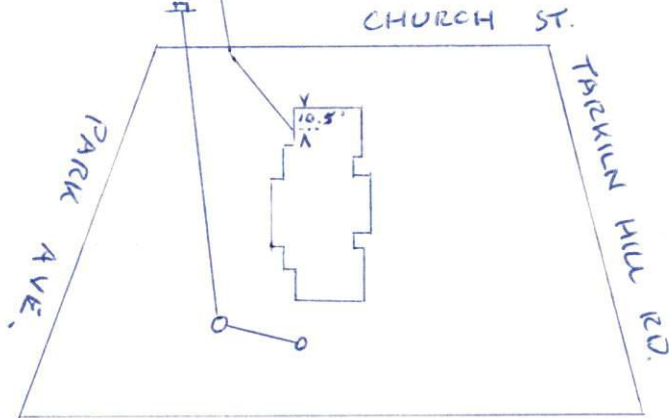

BLDG. & S.D. SCALED FROM AS-BUILT PLAN FILED WITH
PERMIT APPLICATION.