

95

DRAIN

Permit

No. 2087-1905

Maple St.
Chancery to Park

Maple St. Sewer

5" pipe

Dec. 27, 1905 at 11 A.M. by F.C. De Mello

From Property of T. Franklin Gay

Located N.S.


Account Misc. Ledger p. 10

Reconnected - "West End
Sewer Separation Project"

CDM~

As Built 09/1999
See Case B

Chancery St.

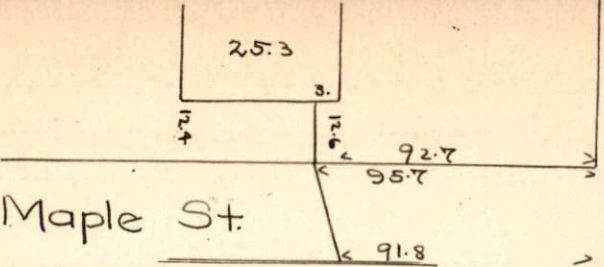

Maple St.

N