

DRAIN

Ash St

#52

Permit

No. 2103-1894

Grove to Hawthorne
Center Ash St Sewer

112⁸⁰ n of Grove, 6" p, March 21/1894 at 10
AM by John Gifford

From property of

Wm L Howland

Located

Ashes 115³⁰ n of Grove

Account Misc. Ledger


p 62

Reconnected - West End

Sewer Separation Project

CDM~

As Built 09/1999
See Case B

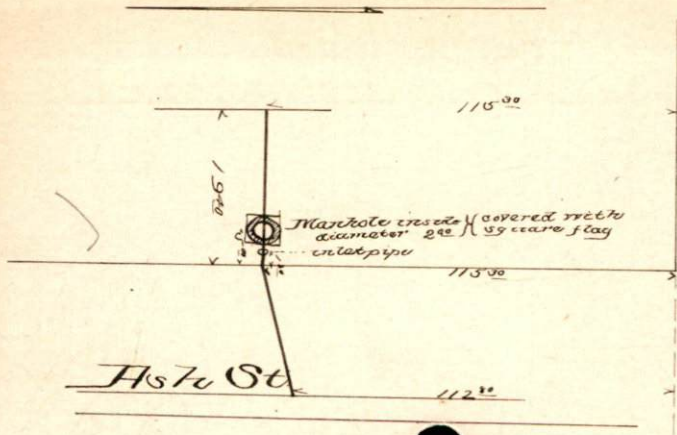

Grove St.