

DRAIN

Wort to St
Chancery to Park
Enters North St Sewer

Permit

No. 2223-1894

68°^{00'} of Park, 5" p. June 6 1894 at 10 AM by
John Gifford

From property of

Alexander Hewins

Located

Worth St s s 71^{20'} of Park


Account Misc. Ledger p 246

Reconnected - "West End

CDM~

Sewer Separation Project"

AS BUILT 09/1/99
See Case B

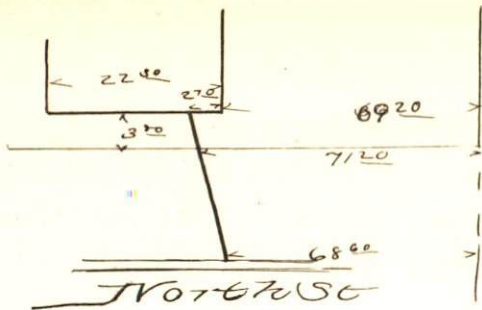

Park St

