

DRAIN

(#166 Clinton St. - Abandoned(?) - New
Connection on Clinton St.)

Maple St

Permit

No. 2263-1894

Ash to Chancery

Centers Maple St Sewer
(March 21)

215²⁰ w of Ash, 6" p. July 3 1894 at 10 PM by
John Gifford.

From property of

James Burns

Located

Maple vs 168¹⁰ e of Chancery


Account Misc. Ledger p 284

Reconnected - "West End
Sewer Separation Project"

CDM~

As Built 09/1999
See Case B

Charney St

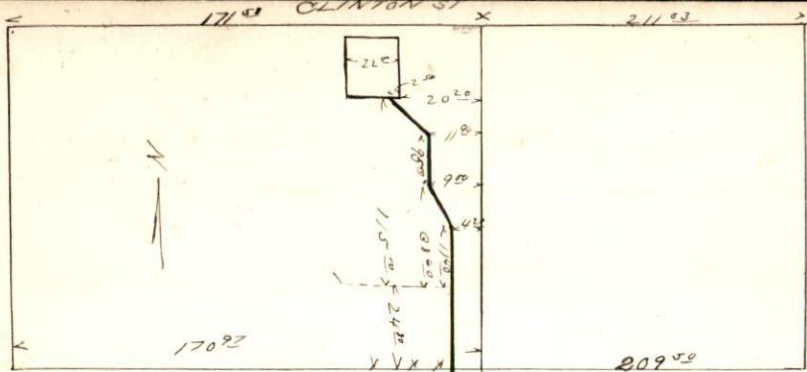

M^H St

Maple St 215° 20'