

✓
DRAIN

No # -

P51/L51
(Behind #235)

Park St

Permit

No. 2301-1894

Cmn to Kempton
Center Park St Sewer

154²⁰ so of Kempton, 6" p. July 23 1894 at 11 AM
by John Gifford

From property of

Andrew C Hathaway


Located

Park us 145⁰ so of Kempton

Account Misc. Ledger p 12.

Reconnected - "West End
Sewer Separation Project"

CMN
As Built 09/1999
See Case B

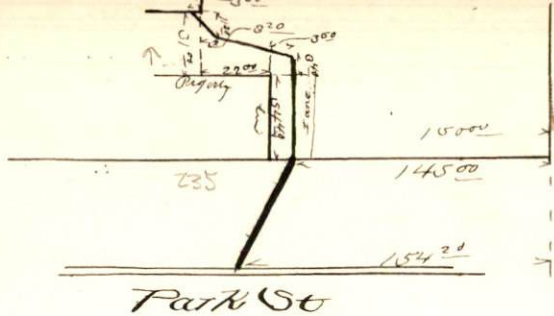

Temperature 50