

✓
DRAIN

(#450 Union St.)

Park St.

Permit

No. 2363-1894

Arnold to Union
Center Park St Sewer

54th so of Union 5" p. Sept 5/1894, at 10 AM
by John Gifford

From property of Joseph Ferguson

Located Park vs 47th so of Union


Account Misc. Ledger p 136

Reconnected - "West End
Sewer Separation Project"

CDM~

As Built 09/1999
See Case B

Union St

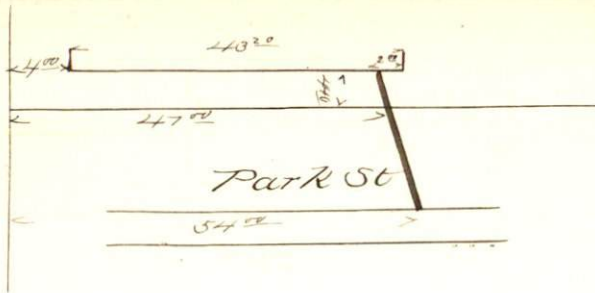

N