

DRAIN

(#25 Chancery St.)

Maple St

Chancery to Park

Enter Maple St Sewer 49⁰⁰

w of Chancery, (branch 45) 5" p. Oct. 13 1894

at 124 M by John Gifford

From property of Mrs. Clara E. Hicks

Located Maple nr 55⁰⁰ w of Chancery

Account Misc. Ledger 7500

Reconnected - "West End


Sewer Separation Project"

CDM~

AS BUILT 09/1999

See Case B

Chauncery St

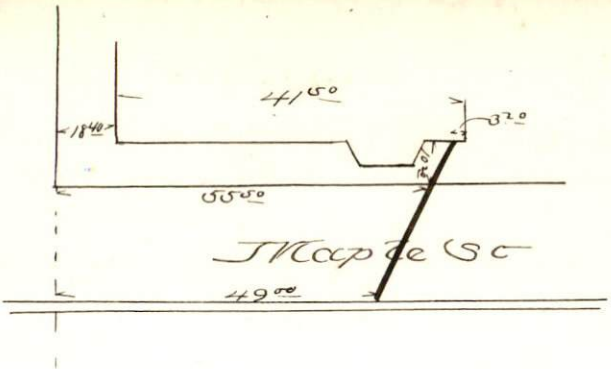

A