

DRAIN

355

Elm St.

Permit

No. 2418-1906

Chancery to Park

Enters Elm St Sewer

5" p. June 19 1906 at 11 A.M. by
F. B. Le Mello

From Property of

Bridget B. Murray

Located

Elm St n.e. of Park

Account Misc. Ledger

p 35


Reconnected - "West-End

Sewer Separation Project"

CDM ~

As-Built 09/1999

See also B

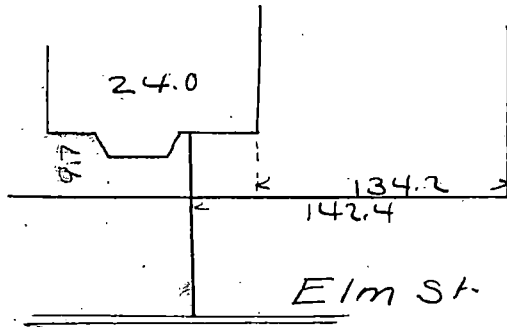

Chancery St.

