

DRAIN

Permit
No. 4915-09.

19
PURCHASE ST.

Coggeshall to Sawyer.

Enters Purchase St. Sewer.
6" Pipe


June 29, 1909 at 11 A.M. by F.C. DeMello

From Property of William E. Dawe

Located W. S.

Account Misc. Ledger

Coggeshall St.

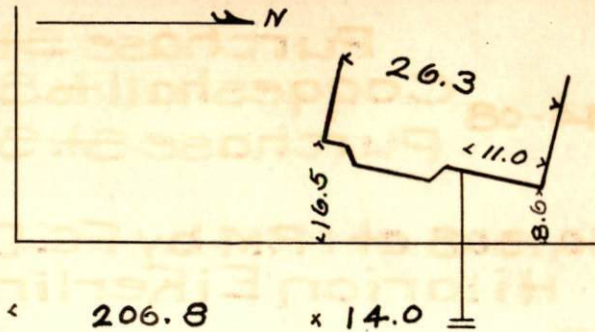

BLDG REPLOTED FROM
AERIAL PHOTO, DRAIN
FROM N. END RELIEF INTERCEPTOR
AS-BUILT (B-605)
6-18-84 IS

Purchase St.