

DRAIN

#72-7A

Permit
No. 4940-09

PARK ST.

Arnold to Union

Enters Park St. Sewer.

6" Pipe

July 13, 1909 at 11 A.M. by F.C. DeMello

From Property of George Gleason

Located e.s.


Account Misc. Ledger

CDM~

Reconnected - "West End
Sewer Separation Project"

As Built 09/1999
See Case B

N

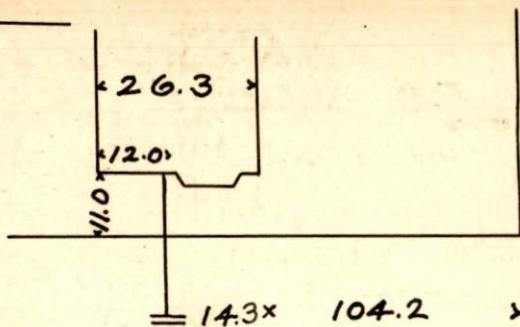

Arnold St.

14.3 104.2

Park St.