

✓
DRAIN

(# 95 Hawthorn - Dwelling in Rear)
Ash St.

Permit

No. 4946-1898

Hawthorn to Maple

Enters Ash St. Sewer. 154⁰⁰

n of Hawthorn

Nov. 14, 1898, 11 a. m. by
F. C. De Mello. 5" Pipe.

From property of John L. Rhodes.

Located Ne. cor Ash & Hawthorn. to settle


Account Misc. Ledger p. 361.

- "West End

CDM ~

Sewer Separation Project"

As Built 09/1999
See Case B

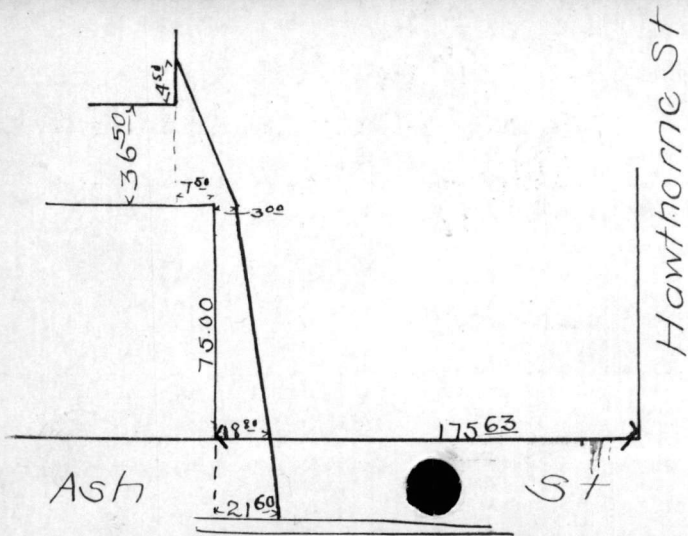

N