

V
DRAIN

#232

Park St.

Elm to Kempton.

Permit
No. 4960-1898.

Enter Park St. Sewer. 208⁰⁰

sof Kempton

Nov. 26, 1898, 11 a. m. by
F. C. De Mello. 5" Pipe.

From property of John Whiteside

Located Park St. es. 206⁰⁰ sof Kempton

Account Misc. Ledger p. 394.


Reconnected - "West End

CDM~

Sewer Separation Project

AS Built 09/1999
See Case B

Park St

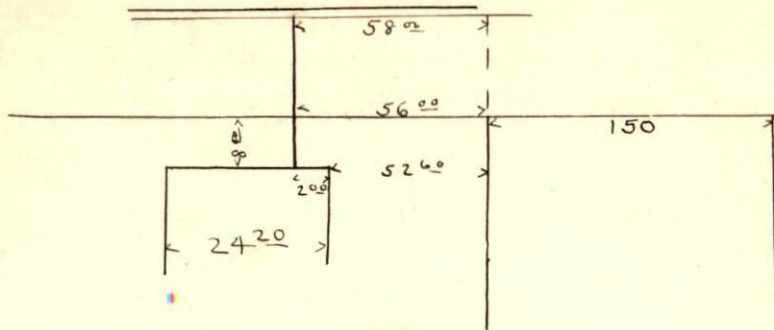

Kempton St