

✓
DRAIN

Park St

Permit
No. 5634-1900Cln to Kempton
Entire Park St Sewer 249.5s. of Kempton. 5"p. June 27/1900 at
1 AM by F. G. Le Mello

From property of

John G. Taber

Located

Park r.s. 244.8 s of Kempton


Account Misc. Ledger p 217

Reconnected - "West End

CDMⁿ

Sewer Separation Project"

As Built 09/1/999
See Case B

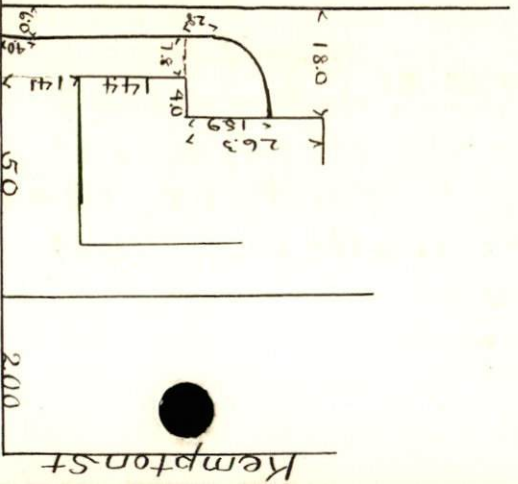

18.0
5.2
16.1
5.0
2.00

Park St.

Rempton St.

