

DRAIN

Park St.

Permit
No. 5694-1900.Keen to Mayfield
Enter Keen St Sewer 45.3wof Keen St, 5"p. August 30 1900 at
1 P. M. by F. B. De Mello

From property of Roderrick McKensie

Located Park W.S. 45.5 wof Keen


Account Misc. Ledger p 273

Reconnected - "West End
Sewer Separation Project"

CDM~

As Built 09/1999
See Case B

Reen St

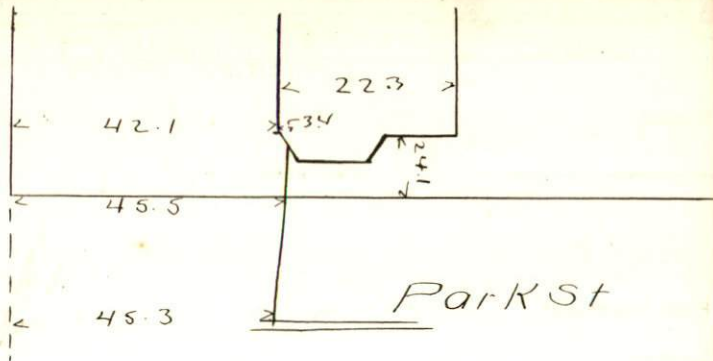

N