

DRAIN

#202 Park St.

Elm Park Street

Chancery to Park

Permit

No. 6427-10

Repaired

Nov. 8, 1910 at 8 A.M. by F.C. De Mello.

From Property of Henry G. Grace

Located 202 Park St. cor. W. Elm Street


Account Misc. Ledger

Reconnected - "West End
Sewer Separation Project"

CDM

AS BUILT 09/1999
See Case B

Park St.

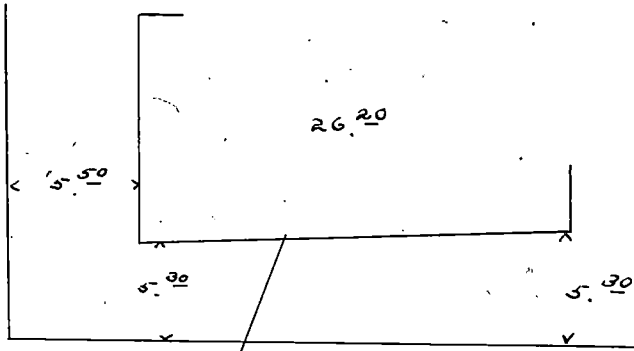

Elm St.