

#370

DRAIN

Park St.

Permit

No. 7916-12

Maxfield to Syamore

enters Park St sewer

6 in. pipe

August 5 1912

From Property of Estella R. Demoranville

Located e. & Park st.

Account Misc. Ledger

F O DEMELLO


Reconnected - "West End

CDM~

Sewer Separation Project"

As Built 09/1999  
See Case B

Sycamore st.

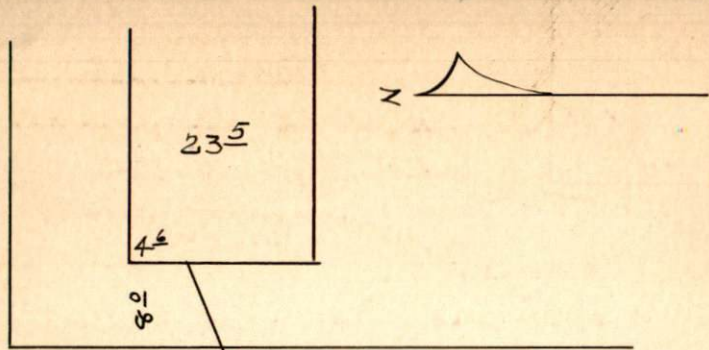

{ 636 } 703 }

Park st.