

#407

DRAIN

Park St

Permit

No. 80515-13

Sycamore to Smith
enters Park St sewer

6 in. pipe

Oct 29, 1913

BY F. C. DEMELLO

From Property of Arthur C. Turner


Located w.e. Park St

Account Misc. Ledger

Reconnected - "West End
Sewer Separation Project"

QDM~

AS BUILT 09/1999
See Case B

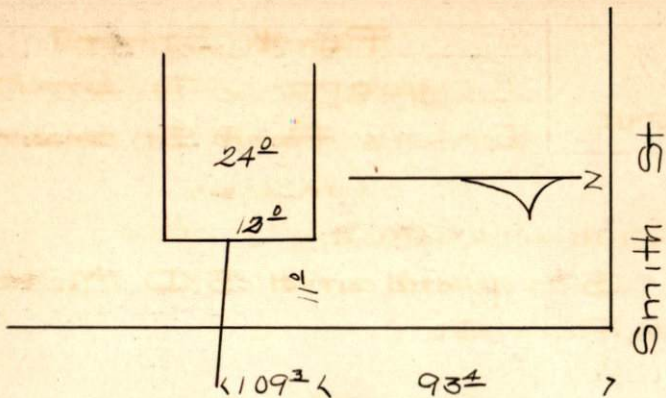

Park

St