

# 273

DRAIN

Park St.

Kempton to Mill

Permit No. 8759-14

enters Mill St. sewer  
6" pipe

May 15<sup>th</sup> 1914

From Property of Catherine A. Naughton

Located W. S. Park St.

Account Misc. Ledger


- "West End

CDM ~

Sewer Separation Project"

As Built 09/1999

See Case B

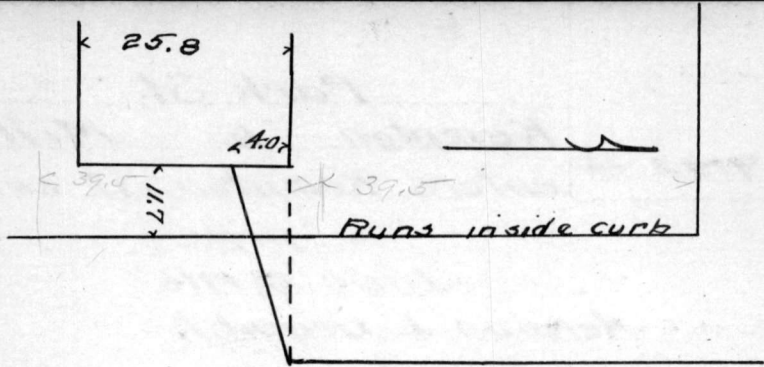

Mill St.