

#402-404

DRAIN

Permit
No. 9115-14

Park St.
Sycamore to Smith
enters Park St. sewer
6" pipe

Nov. 21, 1914

From Property of Victor W. Smith

Located e.s. Park St.


Account Misc. Ledger

Reconnected - "West End
Sewer Separation Project"

CDM~

As Built 09/1999
See Case B

Willis St.

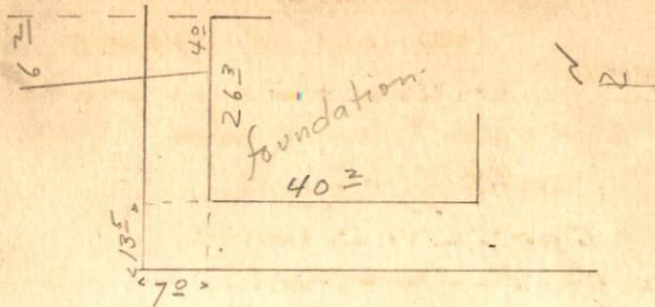

Park St.