


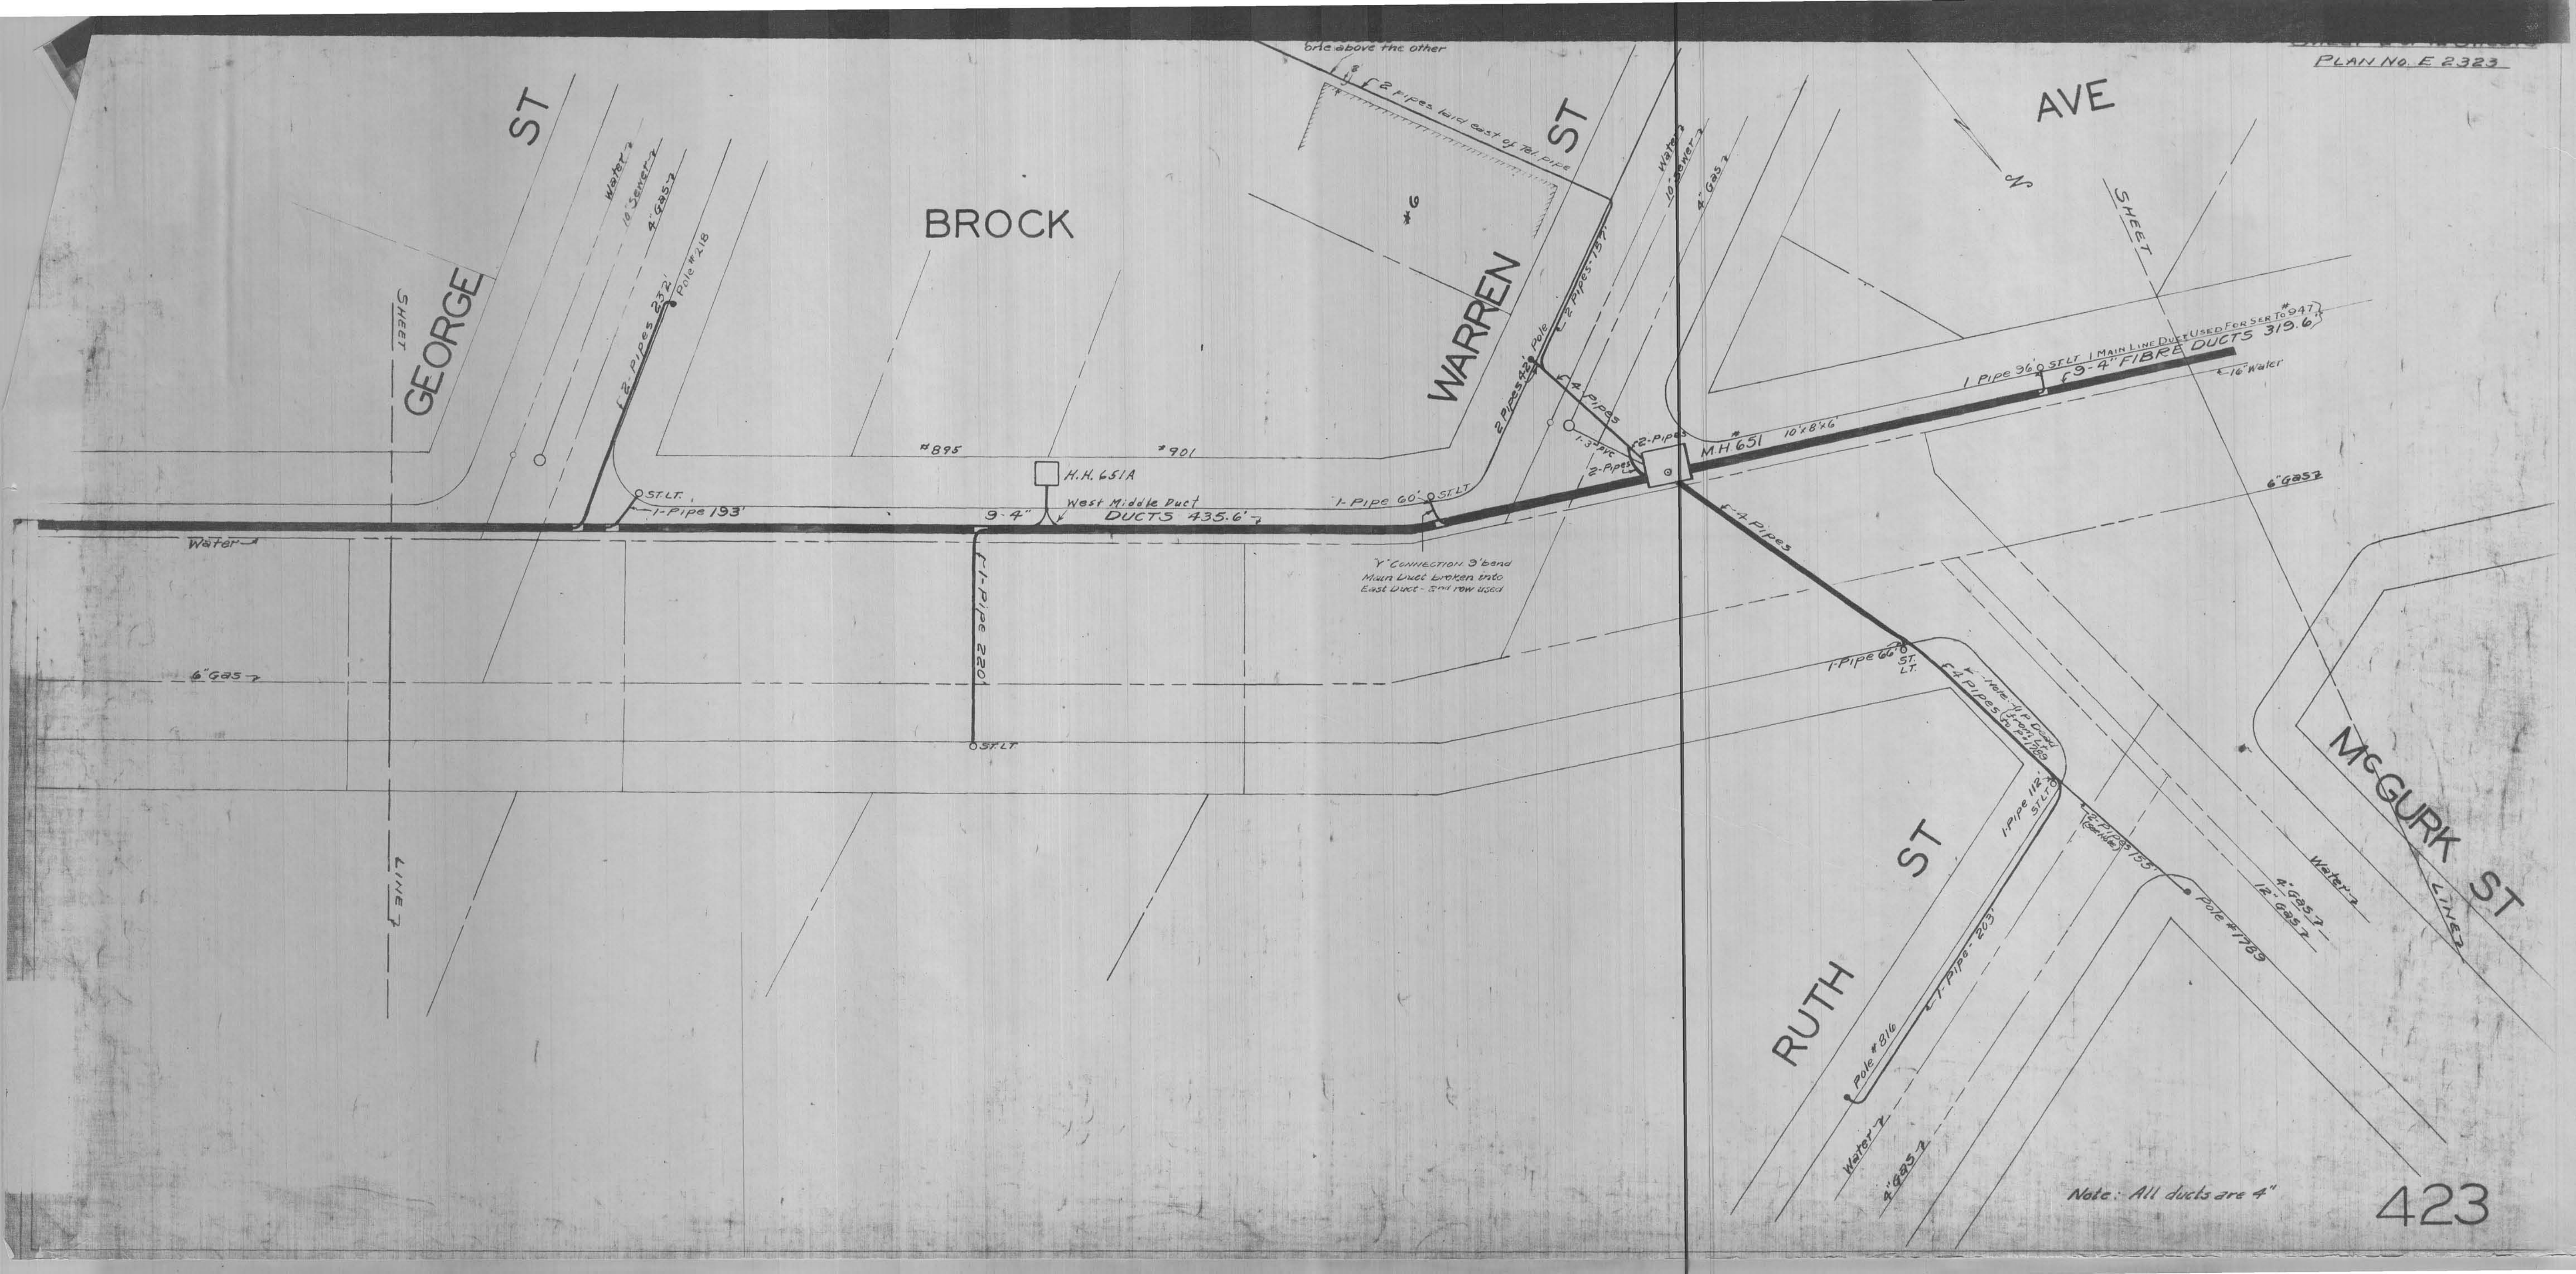

Note: All ducts are 4"