



PERMIT NO.  
24959

CITY OF NEW BEDFORD  
SEWER AND/OR STORM DRAIN PERMIT

DATE 07072021  
Expire date: 07.07.2022

This certifies that permission is granted to

Property Owner John Danahy 4 John Danahy St Dartmouth MA Address 508-984-4054 Tel.

To connect a sewer and/or storm drain located at (S.S.) 5 Forland Circle x Phillips Del  
Assessor's Plot 130D Lot 483 to the sewer and/or storm drain in existing 8" main S.D. 35 Street

on Forland Circle - existing 6" S.D. 35 service is roadway  
To be laid in accordance with the conditions in this application and the City of New Bedford ordinances.  
TYPE OF USE: RESIDENTIAL COMMERCIAL INDUSTRIAL FLOW \_\_\_\_\_ G.P.D.

If applicant other than actual property owner, attach Letter of Authorization from Property Owner.

Name \_\_\_\_\_ Tel. \_\_\_\_\_  
Mailing Address \_\_\_\_\_  
The Bonded Contractor/Drain Layer authorized to perform this work is:  
TS Carver Name \_\_\_\_\_ Address \_\_\_\_\_ Tel. \_\_\_\_\_  
Type of Pipe Required: 6" S.D. 35 PVC

PERMIT EXPIRES ONE YEAR AFTER DATE OF ISSUE

- Requires separate connections for sewage and storm drain where applicable. Storm water cannot be discharged to a sanitary sewer.
  - All work must be inspected and approved by a D.P.I. inspector before backfilling.
  - If this connection is to be part of a private service shared jointly with other building owners, attach copy of Recorded Joint Maintenance Agreement.
  - Permits can be issued to Industrial and/or Commercial Applicants only upon receipt and approval by the Commissioner of Public Infrastructure of required plans and supplemental information.
  - In addition, a City-issued Industrial User Discharge Permit and/or a Sewer Extension/Connection Permit issued by the Commonwealth of Massachusetts D.E.P. shall be required by the City for Industrial Discharge into the sewer system.
- Industrial User Discharge Permit No. \_\_\_\_\_ Date \_\_\_\_\_

Comm. Mass. Sewer Conn./Ext. Permit No. \_\_\_\_\_ Date \_\_\_\_\_  
A Filing and Inspection Fee of \$ 450, plus an Entrance Fee of \$ \_\_\_\_\_ where applicable, must accompany this application.

Bank# College Bank Check# 6006 Date July 7, 2021 Receipt# 311084

Other requirements: \_\_\_\_\_

Connection made to Sewer Part of jointly-shared private line YES NO  
Storm Drain

Applicant agrees to abide by the above terms, as well as all pertinent ordinances of the City of New Bedford, and such other special rules as the Commissioner of Public Infrastructure and/or City Engineer may deem necessary


Signature of Property Owner or Representative  
John Danahy  
Asst. City Engineer

INSPECTOR'S REPORT

INSPECTED BY: \_\_\_\_\_

DATE: \_\_\_\_\_

COMMENTS: \_\_\_\_\_

 

APPROVED \_\_\_\_\_ DISAPPROVED \_\_\_\_\_

SKETCH PLAN

SIGNATURE





## CITY OF NEW BEDFORD

City Hall, Room 308, 133 William Street New Bedford, MA 02740 (508) 979-1540



## FOUNDATION PERMIT

4/13/2021

No. B-20-2972

MSBC Sect. 111.8 - Any permit issued shall be deemed abandoned and invalid unless the work authorized by it shall have been commenced within six (6) months after its issuance.

FEE PAID \$100.00

This certifies that Brooke Clayton

owner/contractor has permission to:

WS- FARLAND CRC

on:

130D  
-483Foundations Only 1-2 Family - 100.00

Providing that the person accepting this permit shall in every respect conform to the terms of application therefore on file in this office; to the provisions of the statute of the Commonwealth and to the by-laws of the City of New Bedford relating to the inspection, erection, enlarging, altering, raising, moving, repairing, or tearing down of a building.

Permit is issued subject to the following special requirements: (Restrictions)

Wiring Inspector



Plumbing Inspector



Building Inspector

YOUR AREA INSPECTOR IS: Matthew Silva

Tel. (508) 979-1540 Between 8:00am - 9:00am

**NOTICE: NOTIFY INSPECTOR 48 HOURS IN  
ADVANCE OF APPLYING SHEATHING OR LATHING**

**OCCUPANCY PERMIT REQUIRED BEFORE OCCUPANCY**  
No Building or Structure shall be used or occupied until the Certificate of Use and Occupancy shall have been issued by the Building Commissioner - MSBC, Sect. 120.1

**This Card Must Be Displayed in a Conspicuous Place on the Premises and Not Torn Down or Removed Until Completion of Work**

SUBJECT TO MASSACHUSETTS  
STATE BUILDING CODE

*David A. Brannan*



6090

5-7017/2110

**Kevin Ponte**  
DBA Kevin Ponte Electric  
4 John Winthrop St  
Dartmouth, MA 02747  
508-989-9043

**PAY**  
TO THE  
ORDER OF

*City of New Bedford*  
*Four hundred fifty*

Citizens Bank  
Massachusetts

MEMO *Super Permit*



AUTHORIZED SIGNATURE

MP

DATE

*7/7/61*  
*\$ 450.00*

DOLLARS

⑈006090⑈ ⑆211070175⑆ 1312553232⑈

MISCELLANEOUS PAYMENT RECPT#: 3410184  
City of New Bedford  
133 William St.  
New Bedford MA 02740

DATE: 07/07/21  
CLERK: a450mmh  
CUSTOMER#: 0

TIME: 15:39  
DEPT:

COMMENT:

CHG: DPISew DPI SEWER PERMI	450.00
-----	
REVENUE:	
1 63906000 422185	450.00
Sewer Permit Fee	
CASH:	
TWO5 101009	450.00
Cash Treasurer Dep W	
-----	

AMOUNT PAID: 450.00

PAID BY: KEVIN PONTE  
PAYMENT METH: CHECK  
MR6090

REFERENCE:

AMT TENDERED:	450.00
AMT APPLIED:	450.00
CHANGE:	.00



MAP 130D  
LOT 487

MAP 130D  
LOT 486

MAP 130D  
LOT 485

S 05°04'30" E

75.00'

MAP 130D  
LOT 483  
8,572 S.F.

MAP 130D  
LOT 482

N 84°53'42" E  
114.30'

S 84°53'42" W  
114.26'

MAP 130D  
LOT 484

EXISTING  
FOUNDATION  
TOP: 103.36

11.5'

13.4'

20.0'

N 05°06'18" W 75.00'

FARLAND

( PRIVATE 50' WIDE )


CIRCLE

AS-BUILT FOUNDATION PLAN - LOT 26

FARLAND CIRCLE

IN

NEW BEDFORD, MA

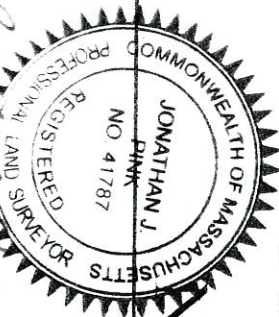

I CERTIFY THAT THE FOUNDATION SHOWN  
HEREON, AS BUILT, CONFORMS TO THE CITY  
OF NEW BEDFORD ZONING SETBACK  
REQUIREMENTS.

DATE: JULY 2, 2021

SCALE: 1" = 20'



ZENITH LAND SURVEYORS, LLC  
1162 ROCKDALE AVENUE  
NEW BEDFORD, MA 02740  
(508) 995-0100

PROFESSIONAL LAND SURVEYOR

DATE