

Length of drain 30'

Billed 1/15/64

✓3

NOTICE TO COMMISSIONER OF PUBLIC WORKS

2 pipe system

Drain Permit **Nº 18193**

City of New Bedford,

Office of City Clerk, Nov. 4, 1963

To Commissioner of Public Works.

Permission has this day been issued to

Charles Vardo

Property owner

889 Wildwood Rd

Address

By

Address

to lay drain from the premises of

Charles Vardo

W. side Wildwood Rd. 30' so. of Kingcroft

to connect with the sewer in

Wildwood Rd

street.

From manhole in street to
property line

City Clerk.

Requires separate entrance for sewage and roof water

RETURN OF FOREMAN

Entered DEC-26 1963

Time

By

COST

Labor	hours	@	
Thibault, J. - 8	"	180	14 40
	"		
	"		
	"		
	"		
	"		
Stock			
14th ON - A ROAD - 12 FT X 2 FT to chg - street opened for sewer <i>off</i>			
Additional Charges to be rendered by Paul & Cleary & Co., Inc.			247 13
Trucking			
Total Cost			261.5
Estimate-cost of laying drain		171 -	
Entrance charges assessed			
Total deposit		171 -	
Balance due City			90.53

Pieces pipe to curb.....

“ “ curb to house.....

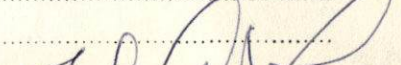
Cut at sewer.....

Cut at curb.....

Size of pipe.....

Correct 0/1

pipe.....

.....

Foreman

Foreman