

CITY OF NEW BEDFORD
APPLICATION FOR LAYING DRAIN

Application **Nº 19443**

Board of Health Permit No.

To the Mayor and City Council:

New Bedford, Mass., June 21, 1972

I hereby request that a drain be laid from the premises of "O" Fuel Co. Inc.
on Hassey St 60' n. of South Street

to connect with the sewer in Hassey street,
the same to be laid in the street and the surface repaired as directed by the Commissioner of Public Works.

I hereby agree to pay at the office of the City Treasurer all cost of performing the above work in the manner specified, in excess of the deposit made herewith, within 10 days after the completion of the work.

It is understood and agreed that the deposit made with this application shall be applied to the payment of the cost of performing the work done, and that any excess of deposit over the cost shall be returned to me by the City Treasurer.

Witness L. Bryant

Antonia Mello

Property owner

25 Elm St New Bedford

Address

By Robert D. Martin

151 Fortiant Neck Rd Fairhaven

Address

Requires separate entrance
for roof water

Consent of Owner of Private Drain

New Bedford, Mass.,

To the Mayor and City Council:

I hereby grant to
the privilege of draining premises

through the private drain owned by me connecting with sewer in
street.

Owner

Estimate and Deposit Requirement

Office of Commissioner of Public Works,

My estimate of the cost of laying the drain described in the above application is

\$ 235.00

Assessed

Entrance charges 15.00

Total deposit required \$ 250.00

George H. Brightman Jr.
Commissioner of Public Works

Certificate of Issue

Office of City Clerk,

The above application, accompanied by City Treasurer's receipt presented this day; whereupon
Permit No. 19443 was issued, and the Commissioner of Public Works notified of the same.


Ellen M. Spaulding
City Clerk

Laid from main in street to iron pipe in property LINE

Owner agrees to supply all necessary

Transite pipe.

Owner guarantees compliance with all applicable sewer ordinances. Storm water drained directly into drain.

 

EASEMENT

Know all men by these presents, that I, VINCENT RUGNETTA of 127 Beekman Street, New York, New York, grant to D. FILLET CO., INC., a corporation duly organized by law, and its successors, transferees or assigns, the perpetual right and easement to erect, lay out and maintain, and enter for the purpose of repairs, a sewer pipe line under the land of this grantor and located as shown on a Plan to be simultaneously recorded herewith and said easement is to extend ten feet on either side of the sanitary sewer line and more particularly shown on said plan.



VINCENT RUGNETTA


COMMONWEALTH OF MASSACHUSETTS

BRISTOL, SS.


NEW BEDFORD

FEBRUARY 2, 1973

Then personally appeared the above named Vincent Rugnetta and acknowledged the foregoing instrument to be his free act and deed, before me,

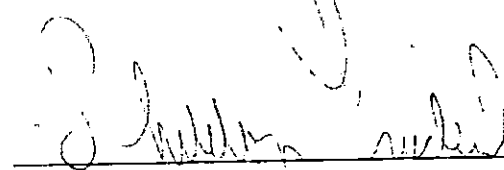

Sheldon Friedland, Notary Public
My commission expires: 11/22/74

 

NOTICE TO COMMISSIONER OF PUBLIC WORKS

Length of drain.....33'

Sewer depth.....6'

Surf. drain.....

Billed 1/14/12

.....2 pipe system

Drain Permit **Nº 19443**

City of New Bedford,

Office of City Clerk, *June 21, 1912*

To Commissioner of Public Works.

Permission has this day been issued to

"O" Fullet Co. Inc.

Property owner

25 Elm St.

Address

PA By *Martin Bros. Co. Inc.*

151 Sciticut Neck Rd Thon

Address

to lay drain from the premises of "O" Fullet Co. Inc.

es Hassey St 60' n of South Street

to connect with the sewer in *Hassey* street.

Laid from main in street to ~~iron~~ pipe in property. *LINE*

Owner agrees to supply all necessary

Eller M. Gaughan City Clerk.

Transite pipe.

Requires separate entrance for sewage and roof water

Owner guarantees compliance with all applicable sewer ordinance

Storm water drained directly into river.

RETURN OF FOREMAN

Entered Aug. 8 & 8/17/ 19 72
 Time 4 P.M.
 By Jesse W. Yarnes

COST

Labor	hours @	
Jesse Yarnes 7 "@	3.75	\$26.25 ✓
Joseph Alguiso 7 "	3.32	23.24 ✓
Norbert St. Pierre 7 "	3.20	22.43 ✓
Wm. Cornero 4 "	3.10	12.36 ✓
Joseph Maco do 7 "	3.60	25.23 ✓
TOM Burk 7 "	3.43	24.04 ✓
Oliver, D. -2 "	3.75	7.50 ✓
Stock Howard, J. -2 "	3.32	6.64 ✓
		<u>\$147.69</u>

Repair 15 X 3 B.T. Street
 Shoring Don Oliver - 2-HRS.
~~30~~

no stock -

Trucking

ordson	35-3-HRS-	@6.55-	19.65 ✓
Trk.	67-2-HR-	@3.00-	6.00 ✓
ompress	52-1-HR	@3.35-	3.35 ✓

Total Cost

224.44

Estimate-cost of laying drain

235-

Entrance charges

15.00

Total deposit

Balance due Martin Conter, Co.

10.56

Refund
 Pieces pipe to curb

" " curb to house

Cut at sewer

Cut at curb

Size of pipe

Correct

Jesse W. Yarnes
 Connection couldn't be made - owner finished drain. Foreman