

CITY OF NEW BEDFORD

APPLICATION FOR LAYING BUILDING SEWER AND/OR DRAIN SERVICE

Application N^o 19753

11/4/74
Date

To the Mayor and City Council:

I hereby request that a building sewer and/or drain be laid for the premises at

Warren Street at Brock Avenue

to connect with the sewer/drain in street,
the same to be laid in the street and the surface repaired as directed by the Commissioner of
Public Works.

I hereby agree to pay at the office of the City Treasurer all cost of performing the above
work in the manner specified, in excess of the deposit made herewith, within 10 days after the
completion of the work.

It is understood and agreed that the deposit made with this application shall be applied
to the payment of the cost of performing the work done, and that any excess of deposit over the
cost shall be returned to me by the City Treasurer.

Witness

Signature of Property Owner

Address

Telephone No.

Plumber's Name

Requires separate entrance
for roof water

Address

Permits to Industrial and/or Commercial Applicants:

Permits can be issued to industrial and/or commercial applicants only upon receipt by
the Commissioner of Public Works of such supplemental information as may be required by
him concerning the quality and quantity of the proposed wastewater discharge.

This information was submitted by.....
Signature of Applicant (owner)

and approved by the Commissioner of Public Works on
Date

Commissioner of Public Works

Estimate and Deposit Requirement

Office of Commissioner of Public Works, 11/4/74

My estimate of the cost of laying the building sewer and/or drain described in the above
application is

Assessed Entrance charges 15 00/100 Total deposit required 15 00/100

Commissioner of Public Works

Certificate of Issue

Office of City Clerk, 11/4/74

The above application, accompanied by City Treasurer's receipt presented this day;
whereupon Permit No. 19753 was issued, and the Commissioner of Public Works
notified of the same.

City Clerk

Laid from main in street to property line.
Owner agrees to supply all necessary mater-
ials and pipe.

Inspection Only

1875



CITY OF NEW BEDFORD

APPLICATION FOR LAYING BUILDING SEWER AND/OR DRAIN SERVICE

Application N^o 19752

11/4/74
Date

To the Mayor and City Council:

I hereby request that a building sewer and/or drain be laid for the premises at west side of E Rodney French Blvd 80' ± south of Ruth St.

to connect with the sewer/drain in E Rodney French Blvd street, the same to be laid in the street and the surface repaired as directed by the Commissioner of Public Works.

I hereby agree to pay at the office of the City Treasurer all cost of performing the above work in the manner specified, in excess of the deposit made herewith, within 10 days after the completion of the work.

It is understood and agreed that the deposit made with this application shall be applied to the payment of the cost of performing the work done, and that any excess of deposit over the cost shall be returned to me by the City Treasurer.

Witness Ethel Griffith

John H. Morgan N.P.N.A.
Signature of Property Owner

134 So Second St.
Address

Telephone No.

Plumber's Name

Requires separate entrance
for roof water

Address

Permits to Industrial and/or Commercial Applicants:

Permits can be issued to industrial and/or commercial applicants only upon receipt by the Commissioner of Public Works of such supplemental information as may be required by him concerning the quality and quantity of the proposed wastewater discharge.

This information was submitted by [Signature]

Signature of Applicant (owner)

and approved by the Commissioner of Public Works on [Signature]

Date

Commissioner of Public Works

Estimate and Deposit Requirement

Office of Commissioner of Public Works, 11/4/74

My estimate of the cost of laying the building sewer and/or drain described in the above application is

Assessed

Entrance charges

Total deposit required

George H. Brightman
Commissioner of Public Works

Certificate of Issue

Office of City Clerk, 11/4/74

The above application, accompanied by City Treasurer's receipt presented this day; whereupon Permit No. 19752 was issued, and the Commissioner of Public Works notified of the same.

Ellen M. Gaughan
City Clerk

Laid from main in street to property line.
Owner agrees to supply all necessary materials and pipe.

STORM DRAIN CONNECTION ONLY - tied in by
D.W.White. INSPECTION EX ONLY. Inspection by
G.H.B.

NEW BEDFORD HOUSING AUTHORITY

Post Office Box A-2081
New Bedford, Massachusetts 02741

FRANCIS J. LAWLER
EXECUTIVE DIRECTOR

CENTRAL OFFICE:
134 SO. SECOND STREET

October 16, 1974

City of New Bedford
Department of Public Works
City Hall
New Bedford, Massachusetts

Attention: Bill Boucher

Re: NB 667-2 - Elderly Project


Gentlemen:

Please be advised that D. W. White Construction Inc., a sub-contractor for F. L. Collins & Sons, Inc., is responsible for the utility work in city streets included in the referenced project.

We therefore request that proper building permits be issued to D. W. White Construction Inc. so that the work may proceed.

Contract documents are on file with the Building Department.

Very truly yours,

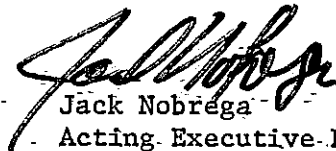

Jack Nobrega
Acting Executive Director

JN:lt

CC: Owen F. Hackett Jr. & Associates

NOTICE TO COMMISSIONER OF PUBLIC WORKS

Length of service *11/28/77*

Sewer depth *1*

Surf. drain

Contractor's Name
(if working on City Property)

Drain Permit **Nº 19753**

City of New Bedford,

Office of D. P. W., *11/4/74*
Date

To Commissioner of Public Works.

Permission has this day been issued to

New Bedford Housing Auth
Signature of Property Owner

134 So Second Street
Address

By *Joel W. Brown*

(#12 Ruth St. - Injex Towers)
Address

to lay a building sewer/drain service from the premises at *Warren Street*
at Brook Avenue

to connect with the sewer/drain in *Warren Street* street.

Laid from main in street to property line.

Owner agrees to supply all necessary materials
and pipe.

Requires separate entrance for sewage and roof water

By *Ellen M. Gushon, Esq.*
INSPECTION ONLY - connection of new force
main being laid in Ruth Street from 100'
+ w. of E. Rodney French Blvd westerly to
Brook Ave. & Warren Sts. All work by

See #19752 for S.D.Conn.

RETURN OF FOREMAN

Entered.....19

Time.....

By.....

COST

Labor	hours @		
	"		
	"		
	"		
	"		
	"		
	"		
	"		
Stock			
Trucking			
Total Cost			
Estimate-cost of laying drain			
Entrance charges			
Total deposit			
Balance due			

Pieces pipe to curb.....

" " curb to house.....

Cut at sewer.....

Cut at curb.....

Size of pipe.....

Correct

Never inspected Foreman

JW 3/7/72