CITY OF NEW BEDFORD

APPLICATION FOR LAYING BUILDING SEWER AND/OR DRAIN SERVICE

	7-22-15
	Date
To the Mayor and City Council:	
I hereby request that a building sewe	er and/or drain be laid for the premises at
W. Side Sugalando	St 413 - not Sutton St
, //	
to connect with the sewer/drain in	Laghland street,
	surface repaired as directed by the Commissioner of
I hereby agree to pay at the office work in the manner specified, in excess of completion of the work.	of the City Treasurer all cost of performing the above f the deposit made herewith, within 10 days after the
It is understood and agreed that the to the payment of the cost of performing cost shall be returned to me by the City 7	e deposit made with this application shall be applied the work done, and that any excess of deposit over the Treasurer.
Witness Getto Boursen Jerry	Signature of Property Owner
Addre	ess Telephone No.
	Plumber's Name
Requires separate entrance	Address
Permits to Industrial	l and/or Commercial Applicants:
the Commissioner of Public Works of suc	and/or commercial applicants only upon receipt by ch supplemental information as may be required by
him concerning the quality and quantity	of the proposed wastewater discharge.
This information was submitted by	
	Sighature of Applicant (owner)
and approved by the Commissioner of F	Sighature of Applicant (owner) Public Works on









July 21/21 I Herby give permission for MR. JERRY Hole to Segn For the The Execustinon & Hook up of Socian mono any often Execuation that Has to be clone on Lot # 6 Roman Morile Tro Brock this

 

SIR, of W. Pron. Line in W. Sidewalk

RETURN OF FOREMAN

Entered 5414 31 1978	
Time 1/0.30 17,111	
By Jane m Longo	
COST	
Labor hours @	,
Tosse Terraes 8" 4.73 37.	34
Nortest ST. Pienes" 4.04-32.32	
ALex. Warn 8 " 3.53 - 28.24 V	
Toe Mello 8 " 3.98-31.84	
Barry De Mello 8" 4.18-35.28=125	.6
"	de la constant
163.	5
Stock	
	3
	ì
100/65 Jmd	gallon.
	,
Trucking	^
# 49-3 hrs. 67.00- 21.	U
2 # 49-5 hrs. 1.00- 116-1-HR. 3.45- 3.	4
22	
C Total Cost	2
Total Cost Estimate-cost of laying drain 45200	
Entrance charges	
Total deposit	
Balance due 262,58	
Pieces pipe to curb 110ff, (11- Prece)	
" " curb to house @ Moff, 1-5ff.	
A Sevent West of 11 DA	
Cut at sewer 5 3 1 Cut at curb 4 ft.	
Size of pipe 6 Transite	
Correct ,	
Le modovores Foreman	
Foreman	