

CITY OF NEW BEDFORD

APPLICATION FOR LAYING BUILDING SEWER AND/OR DRAIN SERVICE

Application No 20165

July 25, 1977

Date

To the Mayor and City Council:

I hereby request that a building sewer and/or drain be laid for the premises at

North side Union Street 50'± east of Sixth Street

to connect with the sewer/drain in Union street,
the same to be laid in the street and the surface repaired as directed by the Commissioner of
Public Works.

I hereby agree to pay at the office of the City Treasurer all cost of performing the above
work in the manner specified, in excess of the deposit made herewith, within 10 days after the
completion of the work.

It is understood and agreed that the deposit made with this application shall be applied
to the payment of the cost of performing the work done, and that any excess of deposit over the
cost shall be returned to me by the City Treasurer.

Witness

Signature of Property Owner

Address

Telephone No.

Plumber's Name

Requires separate entrance
for roof water

Address

Permits to Industrial and/or Commercial Applicants:

Permits can be issued to industrial and/or commercial applicants only upon receipt by
the Commissioner of Public Works of such supplemental information as may be required by
him concerning the quality and quantity of the proposed wastewater discharge.

This information was submitted by

Signature of Applicant (owner)

and approved by the Commissioner of Public Works on

Date

Commissioner of Public Works

Estimate and Deposit Requirement

Office of Commissioner of Public Works, July 25, 1977

My estimate of the cost of laying the building sewer and/or drain described in the above
application is

Assessed

Entrance charges

Total deposit required 15.00

Commissioner of Public Works

Certificate of Issue

Office of City Clerk, July 25, 1977

The above application, accompanied by City Treasurer's receipt presented this day;
whereupon Permit No. 20165 was issued, and the Commissioner of Public Works
notified of the same.

City Clerk

Laid from main in street to property line.

Owner agrees to supply all necessary mater-
ials and transite pipe.

Paid. Insp. only Contractor to utilize existing drain at
property line.

Property line:

Part. Inss. only. Contractor to utilize existing drain as










7/25

Bill This is OK
with me

Jack T.

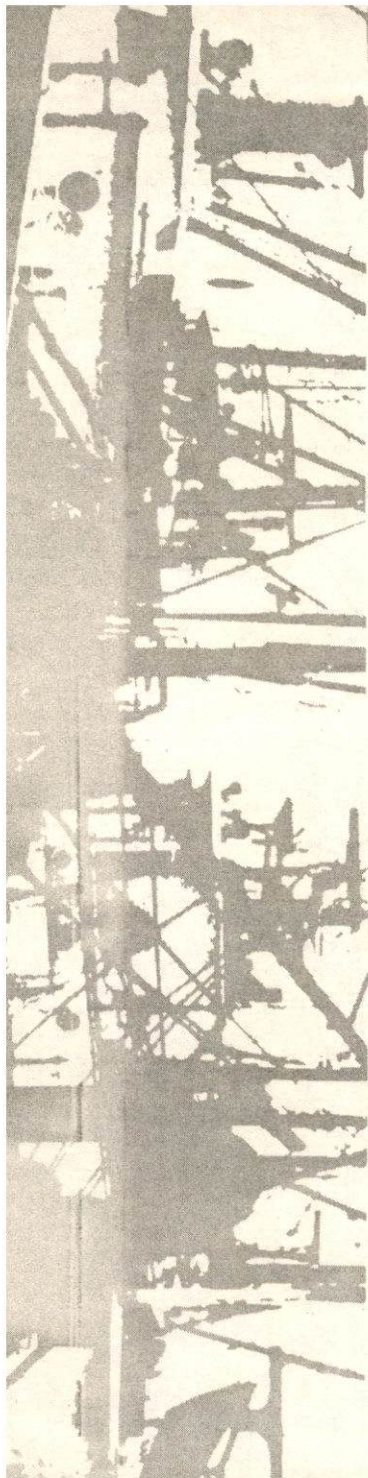

Permit No. 20165

CITY OF NEW BEDFORD
DEPARTMENT OF PUBLIC WORKS

Supplementary Information Required from Commercial or
Industrial Firms in Addition to Issuance of Sewer Entrance Permit

- ✓ A. Architect's floor plan showing proposed connections to building drain (inside building):
— B. Architect's detail drawings of any pretreatment or equalization equipment:
C. Site plan showing:

- ✓ (1) Building and location of building sewer
✓ (2) Proposed connection to public sewer
— (3) Profile of building sewer
— (4) Plan and profile of storm drain
— (5) Location of control manhole
(Standard type — preferably between property line and public sewer.)

D. Wastewater Information:

Date: July 20 77

- ✓ (1) Name of firm: MR. DONUT
✓ (2) Address: COR. UNION & SIXTH N.B. MASS.
✓ (3) Name and title of person completing form. (company representative):
JAMES F. MASSE JFM Corp (Pres.) (Builder)
— (4) Industry type (SIC Number):
✓ (5) Number of Employees: 12 + -
— (6) Principal products manufactured, produced, processed or sold: DONUTS
& PASTRY'S
— (7) Sources of water supply: Municipal ✓ Well
— (8) Estimated volume of water to be used per day: 100 + - gallons.
— (9) Flow gauges in plant influent effluent.
— (10) Water consumed in processes: 10 %.
— (11) Recycled water: %.
— (12) Cooling water: %.
✓ (13) Number of operating days per week: 7
— (14) Number of shifts per day: 3
— (15) Type of discharge: continuous ✓ batch.
— (16) If batch per shift.
✓ (17) Estimated volume of wastewater discharged daily 80 + - gallons.
— (18) Wastewater abatement practices to be used:
— (a) Process changes:
— (b) Changes in raw materials:
— (c) Recycling methods:
— (d) Wastewater treatment equipment:
— (e) Monitoring devices:
— (f) Sampling and testing procedures:
— (19) Expected constituents of final wastewater discharge:
(a) pH (d) Cl Req'm't. mg/l
(b) Grease/Oil mg/l (e) S. S. mg/l
(c) C O D mg/l (f) Color mg/l

✓ (20)

Signature of Property Owner

(JAMES CONNORS)

Date

7/20/77

CITY OF NEW BEDFORD
DEPARTMENT OF PUBLIC WORKS




