

CITY OF NEW BEDFORD

APPLICATION FOR LAYING BUILDING SEWER AND/OR DRAIN SERVICE

Application **Nº 20744**

6-17-83
Date

To the Mayor and City Council:

I hereby request that a building sewer and/or drain be laid for the premises at N.S. SHAW ST. E. OF KING ST. INSTALL 2 NEW M.H.'S ON MAINS
INSTALL SWEEPS ON SAN MAIN INTO NEW M.H. CITY TO SUPPLY SWEEPS
to connect with the sewer/drain in SHAW ST. street,
the same to be laid in the street and the surface repaired as directed by the Commissioner of Public Works.

I hereby agree to pay at the office of the City Treasurer all cost of performing the above work in the manner specified, in excess of the deposit made herewith, within 10 days after the completion of the work.

It is understood and agreed that the deposit made with this application shall be applied to the payment of the cost of performing the work done, and that any excess of deposit over the cost shall be returned to me by the City Treasurer.

Witness Bill Bunch CHAMBERLAIN MFG. CO. 117 KING ST.
Signature of Property Owner

By Donald C. Jayne 996-5621 X128
Address NAME Telephone No.
D W WHITE CONL CO
Plumber's Name
CONTRACTOR

Requires separate entrance
for roof water

Address

Permits to Industrial and/or Commercial Applicants:

Permits can be issued to industrial and/or commercial applicants only upon receipt by the Commissioner of Public Works of such supplemental information as may be required by him concerning the quality and quantity of the proposed wastewater discharge.

This information was submitted by Donald C. Jayne
Signature of Applicant (owner)

and approved by the Commissioner of Public Works on 6-17-83
Date

Robert J. Carter
Commissioner of Public Works

Estimate and Deposit Requirement

Office of Commissioner of Public Works, 6-17-83

My estimate of the cost of laying the building sewer and/or drain described in the above application is 50.00

Assessed
Entrance charges Total deposit required 50.00

Robert J. Carter
Commissioner of Public Works

Certificate of Issue

Office of City Clerk, 6-17-83

The above application, accompanied by City Treasurer's receipt presented this day; whereupon Permit No. 20744 was issued, and the Commissioner of Public Works notified of the same.

Janice Davidson
City Clerk

Laid from main in street to property line.
Owner agrees to supply all necessary materials and PVC SDR 35 pipe.

ALL WORK MUST BE INSPECTED BY
D. P. W. INSPECTOR BEFORE BACKFILLING

100

100

100

Permit No.

20744

CITY OF NEW BEDFORD
DEPARTMENT OF PUBLIC WORKS

Supplementary Information Required from Commercial or
Industrial Firms in Addition to Issuance of Sewer Entrance Permit

- A. Architect's floor plan showing proposed connections to building drain (inside building):
- B. Architect's detail drawings of any pretreatment or equalization equipment:
- C. Site plan showing:
- (1) Building and location of building sewer
 - (2) Proposed connection to public sewer
 - (3) Profile of building sewer
 - (4) Plan and profile of storm drain
 - (5) Location of control manhole
(Standard type — preferably between property line and public sewer.)

D. Wastewater Information:

Date: March 16, 1983

- (1) Name of firm: Chamberlain Mfg. Corp. New Bedford Division
- (2) Address 117 King Street, New Bedford, Ma. 02745
- (3) Name and title of person completing form. (company representative):
Donald Sargent, Plant Engineer
- (4) Industry type (SIC Number): 3483 -2
- (5) Number of Employees: 1,200
- (6) Principal products manufactured, produced, processed or sold:
U.S. Department Of Defense Projectiles
- (7) Sources of water supply: Municipal ☒ Well
- (8) Estimated volume of water to be used per day: No Change gallons.
- (9) Flow gauges in plant ☒ influent ☒ effluent.
- (10) Water consumed in processes: No Change %.
- (11) Recycled water: No Change %.
- (12) Cooling water: No Change %.
- (13) Number of operating days per week: 7
- (14) Number of shifts per day: 3
- (15) Type of discharge: ☒ continuous ☐ batch.
- (16) If batch per shift.
- (17) Estimated volume of wastewater discharged daily No Change gallons.
- (18) Wastewater abatement practices to be used:
 - (a) Process changes: No Change
 - (b) Changes in raw materials: No Change
 - (c) Recycling methods: No Change
 - (d) Wastewater treatment equipment: No Change
 - (e) Monitoring devices: No Change
 - (f) Sampling and testing procedures: No Change
No Change On The Following
- (19) Expected constituents of final wastewater discharge:

(a) pH	(d) Cl Req'm't.
(b) Grease/Oil	(e) S. S.
(c) COD	(f) Color
- (20) Signature of Property Owner

Date

SANITARY SEWERAGE ONLY.
D.U. Bill Bourke









→ 10

CHAMBERLAIN HFE.

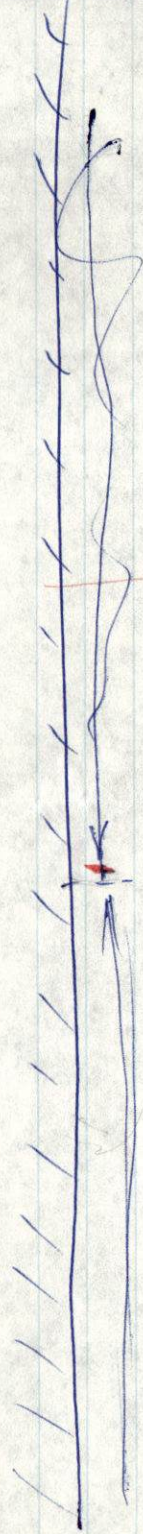

→

KING ST.

4 Scatterers
to S.D.


20'

24' STORM

8"

CHURCH ST.

SHAW ST.

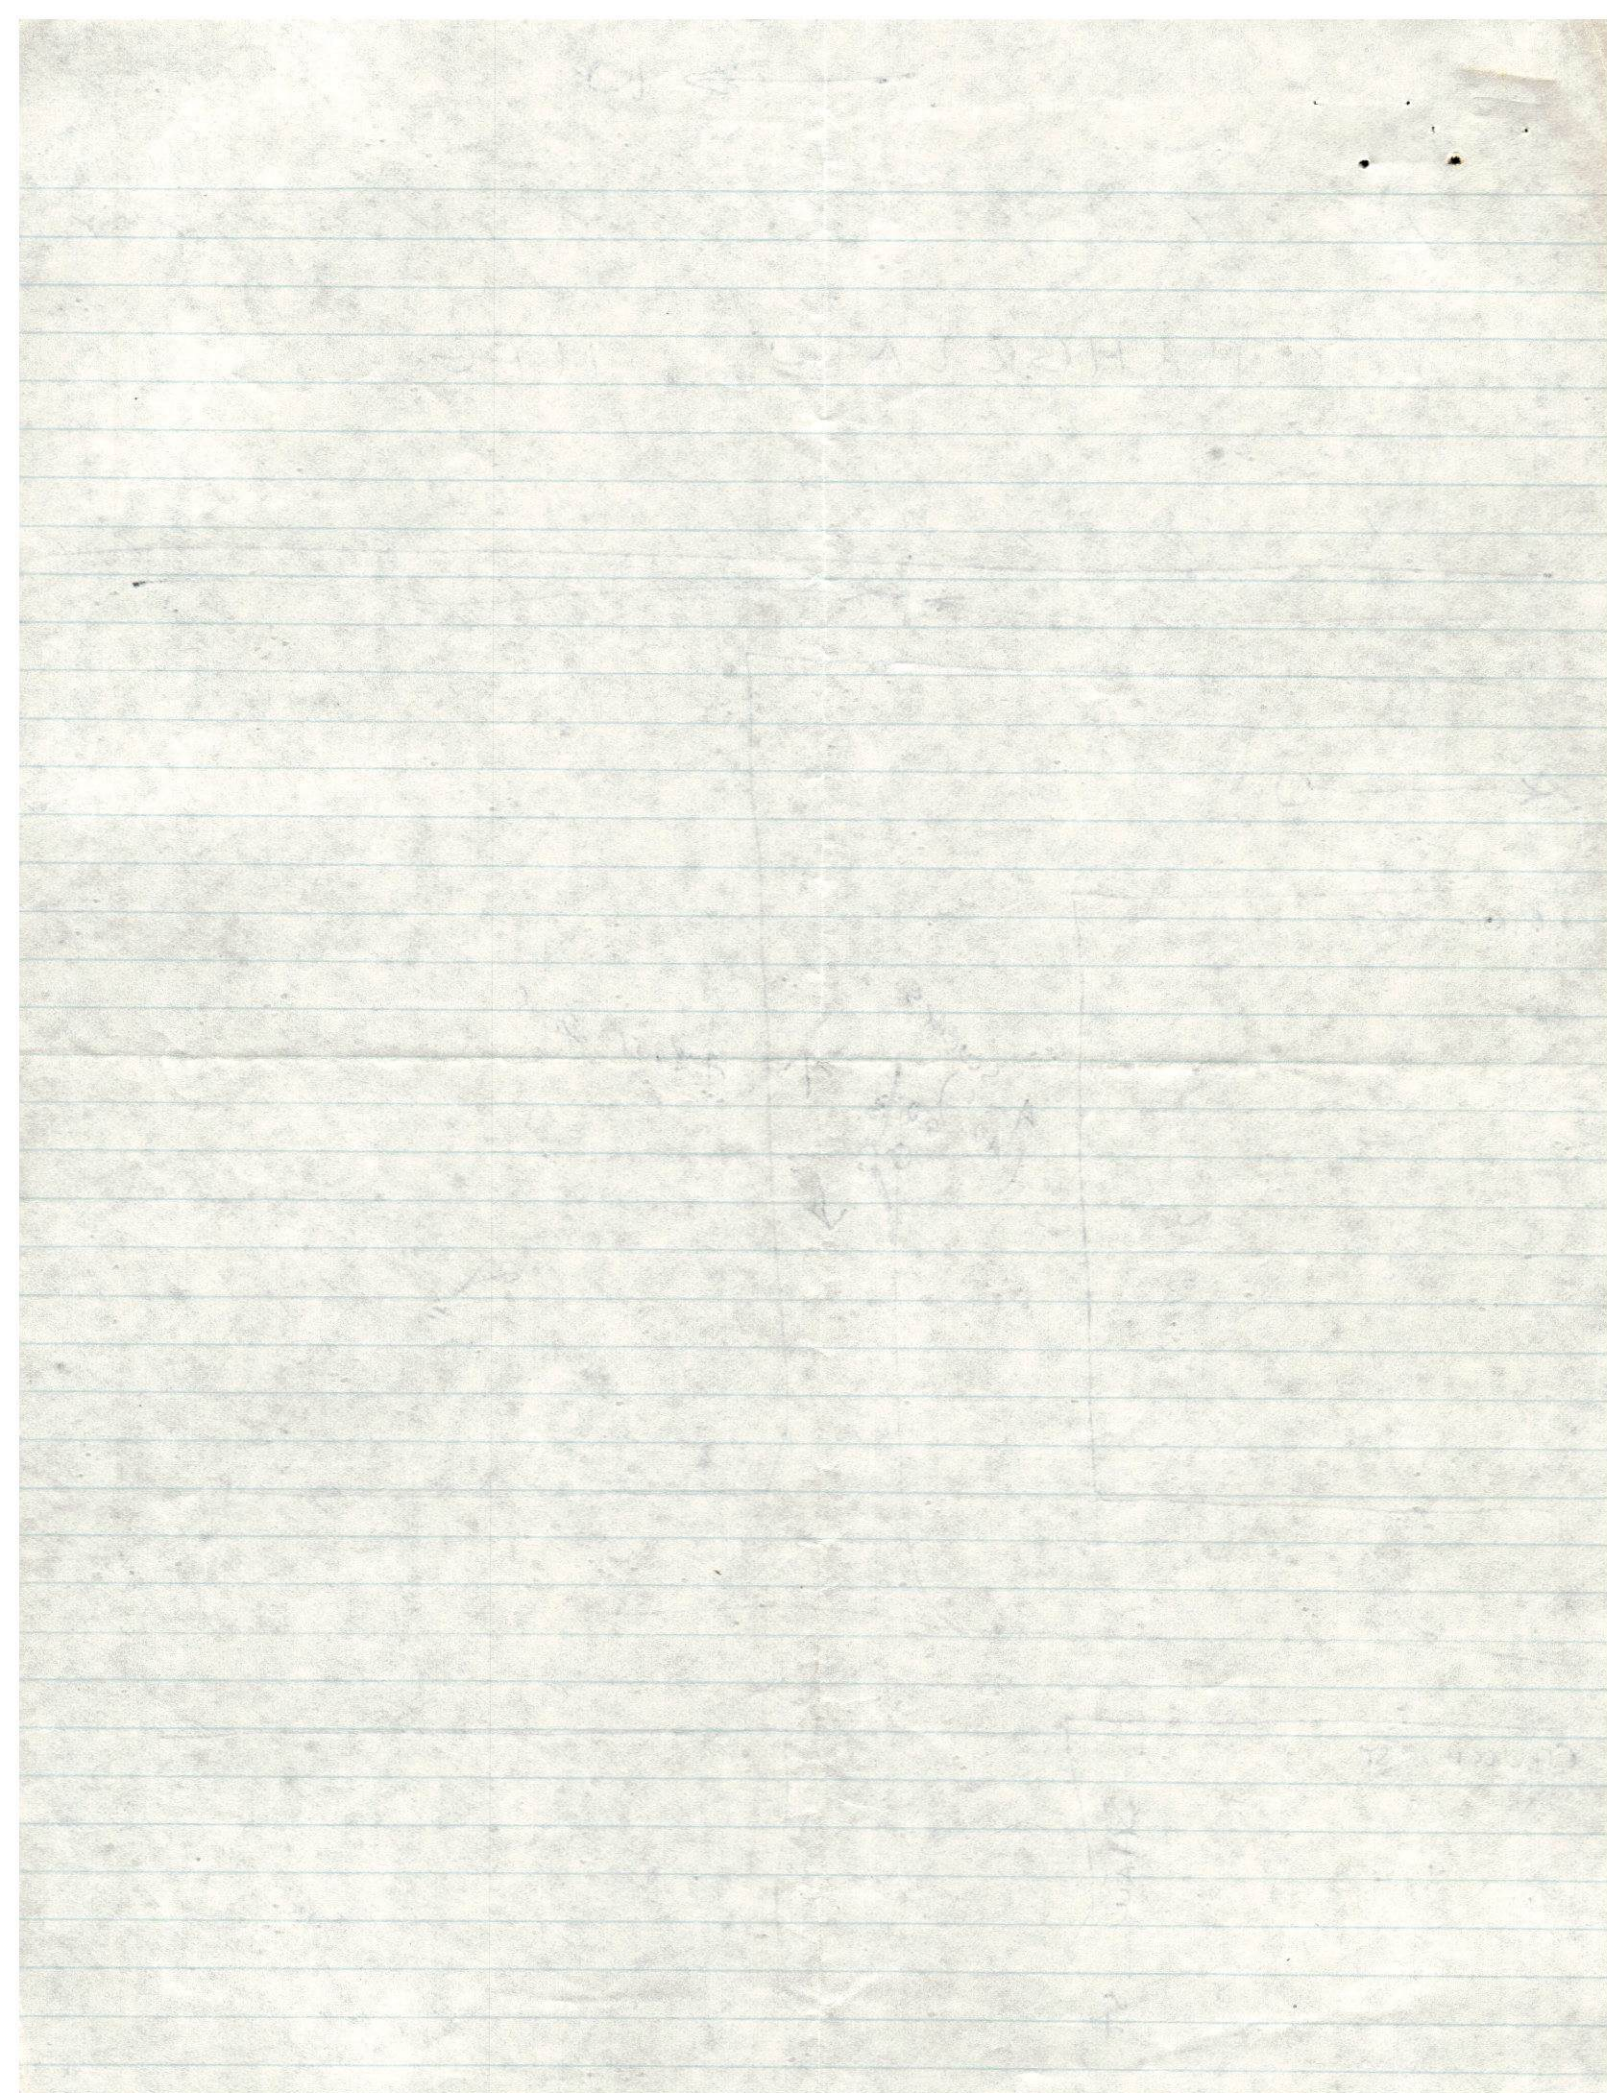



Chamberlain

Chamberlain Manufacturing Corporation
New Bedford Division
117 King Street, New Bedford, Massachusetts 02741
Telephone (617) 996-5621

March 16, 1983

City Of New Bedford
Department Of Public Works

Dear Sir:

This Permit Request is for relocation of tie in to existing City Sewer and Storm Drain on the West End of Shaw St. at the intersection of King.

Presently, both Storm and Sewer terminate at the end of Shaw St. in a Tee and extend North and South on our Property.

We are proposing to construct an addition to our existing Facility as shown on the attached Print.

This proposed addition would extend beyond the existing underground piping as indicated.

We plan to relocate these underground services out from under the proposed Slab and Foundation into the existing Parking Lot. This will facilitate any future repair or maintenance.

The Lines, which will be relocated, would include Storm Drain, Sewer Drain and Sprinkler Yard Main.

Factory Mutual has already approved the proposed relocation of the Sprinkler Main.

To facilitate this relocation, we propose to tie into the municipal lines at a point several feet east of their existing location.

We propose to extend our existing Sewer Line to the North End of the Building and leave provisions for future use.

All existing connections to both Storm and Sewer would remain as is and just be extended to meet the relocated piping.

There will be no new connections (with the exception of 2 Drain Grates at Overhead Doors) to either the Sewer or Storm Drains.







March 16, 1983
City Of New Bedford
Department Of Public Works
Page 2

The addition will be used for Production Equipment which will not need these services and will not change any of our existing Influent or Effluent Flow by volume or content.

If you need additional information, please contact the undersigned.

Donald Sargent, PE.
Plant Engineer

DS/rb

