

Received

DEC 13 2011

PERMIT NO.
24264

**CITY OF NEW BEDFORD
SEWER AND/OR STORM DRAIN PERMIT**

DATE 12/13/11
Exp 12/13/12

This certifies that permission is granted to

Property Owner: The Harry Pearson Trust
Address: Deborah Woodhouse, TRS
Tel.: 74 Birchtree Dr. Westwood, MA
Tel.: 781 336 4543

To connect a sewer and/or storm drain located at 162 Auburn St
Assessor's Plot 75 Lot 158, to the sewer and/or storm drain in 6" Sewer main EXT. in Street Connect into New sewer

To be laid in accordance with the conditions in this application and the City of New Bedford ordinances.

TYPE OF USE: RESIDENTIAL COMMERCIAL INDUSTRIAL FLOW 440 G.P.D.

If applicant other than actual property owner, attach Letter of Authorization from Property Owner.

Name..... Tel.....

Mailing Address.....

The Bonded Contractor/Drain Layer authorized to perform this work is:

The Bonded Contractor/Drain Layer authorized to perform this work is:
W.C. Smith & Son Inc., 148 Westview St. N.B. MA 508.995-1449
 Name _____ Address _____ Tel. _____
 Type of Pipe Required: PVC SDR-35

PERMIT EXPIRES ONE YEAR AFTER DATE OF ISSUE

- Requires separate connections for sewage and storm drain where applicable. Storm water cannot be discharged to a sanitary sewer.
- All work must be inspected and approved by a D.P.I. inspector before backfilling.
- If this connection is to be part of a private service shared jointly with other building owners, attach copy of Recorded Joint Maintenance Agreement.
- Permits can be issued to Industrial and/or Commercial Applicants only upon receipt and approval by the Commissioner of Public Infrastructure of required plans and supplemental information.
- In addition, a City-issued Industrial User Discharge Permit and/or a Sewer Extension/Connection Permit issued by the Commonwealth of Massachusetts D.E.P. shall be required by the City for Industrial Discharge into the sewer system.

Industrial User Discharge Permit No. Date

Comm. Mass. Sewer Conn./Ext. Permit No. Date

A Filing and Inspection Fee of \$450.00, plus an Entrance Fee of \$..... where applicable, must accompany this application.

Bank# Bank of America Check# 117 Date 12/1/2011 Receipt# 09103

Other requirements: Install 100 FT of 8' PVC pipe + 1 dead end-sewer manhole, sawcut all edges of trench. 24 hr notice for all inspections

Connection made to Sewer Part of jointly-shared private line YES NO
Storm Drain

Applicant agrees to abide by the above terms, as well as all pertinent ordinances of the City of New Bedford, and such other special rules as the Commissioner of Public Infrastructure and/or City Engineer may deem necessary

City Engineer

Signature of Property Owner or Representative


INSPECTED BY: _____
DATE: 12/19/11
COMMENTS: _____

COMMENTS:

APPROVED

DISAPPROVED

SIGNATURE *Det / Enk*

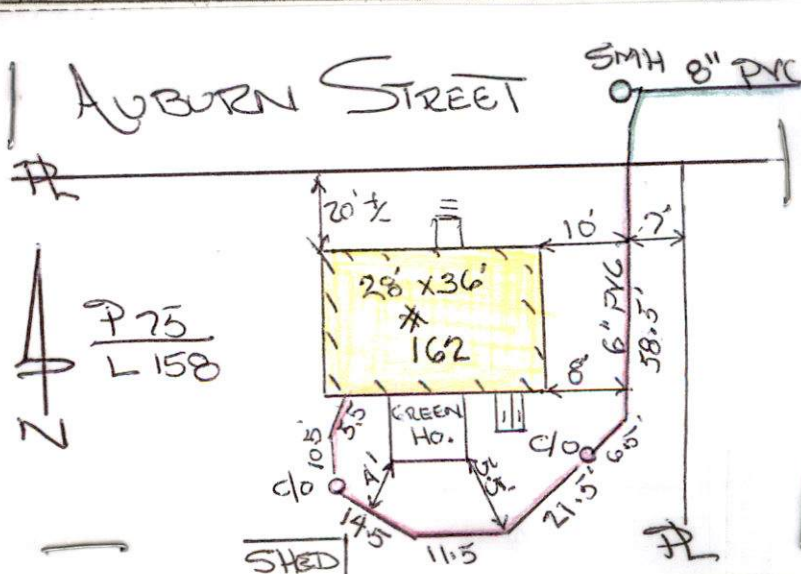

The Louise Agnes Pearson Realty Trust of 2007
Deborah P. Woodhouse, Trustee
162 Auburn Street
New Bedford, MA 02740

December 1, 2011


City of New Bedford
Engineering Department
1105 Shawmut Avenue
New Bedford, MA 02746

Re: 162 Auburn Street
New Bedford, Massachusetts

Dear Sir or Madam:

Please accept this letter as authorization to allow Eric Smith of W.C. Smith & Sons, Inc. and our attorney, Matthew J. Downey of Downey & Downey, P.C. to act on behalf of the owner of the above-referenced property in connection with the sewer extension and sewer service tie-ins for the above property. With this authorization both said Eric Smith and Matthew J. Downey shall have the authority to sign any and all permit applications and pay any and all fees that may be due in connection therewith.

Sincerely,

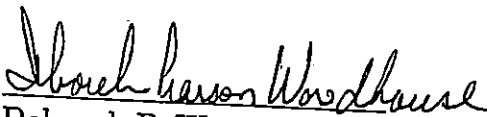
Deborah P. Woodhouse, Trustee
of The Louise Agnes Pearson Realty Trust of 2007

No. 11-07

FEE

68.00

COMMONWEALTH OF MASSACHUSETTS

Board of Health, City of New Bedford, MA.

DISPOSAL SYSTEM CONSTRUCTION PERMIT

Permission is hereby granted to: Construct () Repair () Upgrade () Abandon (X) an individual sewage disposal system
at 162 August St as described in the application for


Disposal System Construction Permit No. 11-07, dated 12/14/11.

Provided: Construction shall be completed within three years of the date of this permit. All local conditions must be met.

Form 1255 Rev. 5/96 A.M. Sulkin Co. Boston, MA

Date 12/14/11

Board of Health

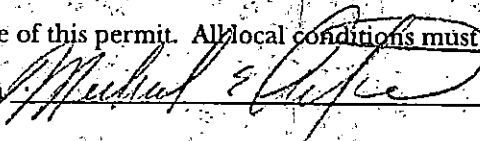



Department of Public Infrastructure

Ronald H. Labelle
Commissioner

Water
Wastewater
Highways
Engineering
Cemeteries

CITY OF NEW BEDFORD

Scott W. Lang, Mayor

TO: Eric Smith, WC Smith & Sons

FROM: Michele E. Silva, Clerk of the Works

DATE: December 1, 2011

SUBJ: Sewer main extension (100 feet) and 2 sewer service connections
Auburn St., New Bedford

Step 1 – Obtain a Sewer Main Extension Permit from the Department of Public Infrastructure for the installation of 100 feet of 8" PVC sewer main pipe and a dead-end sewer manhole. The cost of this permit is \$450, plus \$4/LF (\$4 time 100 linear feet = \$400) total cost of sewer main extension permit is \$850.00.

The Engineering Company will also be required to file a BRP WP (72 – Sewer Extension less than 1,000 feet) permit with DEP.

Step 2 - Once the sewer main has passed inspection, you will then need an Abandonment of Septic System for house #162 Auburn St.

Step 3 – Obtain the 2 sewer service permits (1 for 162 Auburn St. and 1 stub installed to the property line for a future house on Lots 160 & 161). The cost for each sewer service permit is an additional \$450 each.

This department will inform the Environmental & Conservation Commission of this proposed work. You might be required to perform additional work according to their rules & regulations.

The property owner may give you a signed Permission Slip to obtain all permits on their behalf.

Should anyone have any questions, please feel free to contact the Repair Division at 508-991-6150.

Duarte Andrade

From: Michele Avila-Silva
To: Sarah Porter
Cc: Duarte Andrade; Ana S. Rosa; Manuel Silva
Subject: RE: Auburn St sewer extension dec 2011.doc
Attachments:

Sent: Fri 12/2/2011 6:52 AM

Thanks Sarah

From: Sarah Porter
Sent: Thursday, December 01, 2011 3:34 PM
To: Michele Avila-Silva
Cc: Scott Alfonse; Cheryl L. Henlin
Subject: RE: Auburn St sewer extension dec 2011.doc

Michele, We have looked at the plans and Rick does not require a permit from Conservation or Env Stewardship

Thank you

Sarah

From: Michele Avila-Silva
Sent: Thursday, December 01, 2011 12:28 PM
To: Sarah Porter; Scott Alfonse
Cc: Ronald Labelle; Zeb Arruda; Duarte Andrade; Manuel Silva; Ana S. Rosa
Subject: Auburn St sewer extension dec 2011.doc

Duarte Andrade


From: Sarah Porter **Sent:** Thu 12/1/2011 1:42 PM
To: Michele Avila-Silva; Scott Alfonse
Cc: Ronald Labelle; Zeb Arruda; Duarte Andrade; Manuel Silva; Ana S. Rosa
Subject: RE: Auburn St sewer extension dec 2011.doc
Attachments:

Michele, please inform Rick I need to see his site plan to determine if he requires a permit from Conservation


Thank you


Sarah

From: Michele Avila-Silva
Sent: Thursday, December 01, 2011 12:28 PM
To: Sarah Porter; Scott Alfonse
Cc: Ronald Labelle; Zeb Arruda; Duarte Andrade; Manuel Silva; Ana S. Rosa
Subject: Auburn St sewer extension dec 2011.doc

 Attachments can contain viruses that may harm your computer. Attachments may not display correctly.

Duarte Andrade

From: Michele Avila-Silva **Sent:** Thu 12/1/2011 12:28 PM
To: Sarah Porter; Scott Alfonse
Cc: Ronald Labelle; Zeb Arruda; Duarte Andrade; Manuel Silva; Ana S. Rosa
Subject: Auburn St sewer extension dec 2011.doc
Attachments:  [Auburn St sewer extension dec 2011.doc\(43KB\)](#)

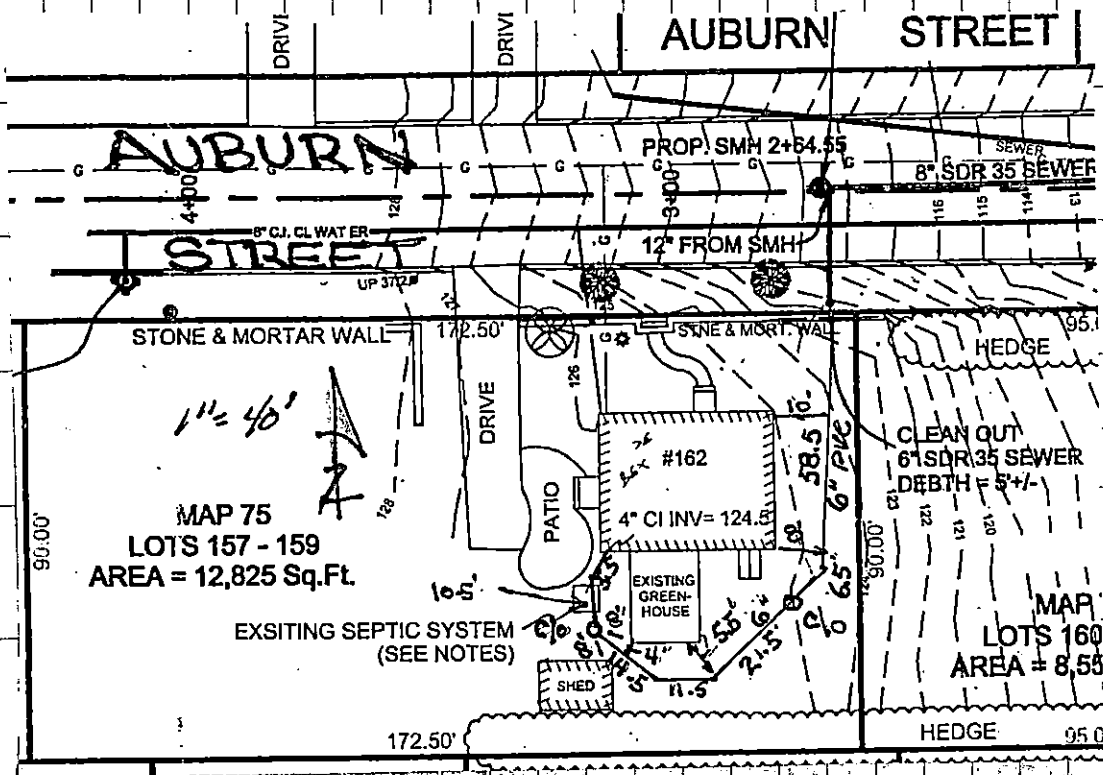

162 AUBURN ST.

COVER INSP
 DATE: 12/19/11
 OFFIC: MC SMITH
 LOCATION: 162 AUBURN
 REPLACE SEPTIC w/ CITY
 PERMIT # 24264
 INSP. BOB FALCONE
 Submit to for
 RECORD + BILLING