

O.K.

NOTICE TO SUPERINTENDENT OF STREETS.

Drain Permit No. 8336

City of New Bedford,

Office of City Clerk, JUN 23 1913 191

To Superintendent of Streets.


Permission has this day been issued to

Name Sarah Kovick Address 263 Acushnet Ave.

to lay drain from premises Sarah Novick, 232 So. Front
Street,

to connect with sewer in Front St. street.

✓



 City Clerk.

Return of Foreman.

Entered June 30 1913.

Time 10 A.M.

By Frank DeMello

COST.

Labor	25 1/2	hours @	31	7	91
	8 1/2	"	34	2	92
	3	"	50	1	50
		"		12	89
		"			
		"			
		"			
		"			
Stock	Same as for Betterment			25	
	Manuel Jacinthe				
Carting				50	
Total Cost				13	14
Deposit				20	00
Balance due					

Pieces pipe to curb

" " curb to house 2 ft.

Cut at Sewer

Cut at curb

Size of pipe 6"

Correct

6.86

Foreman