


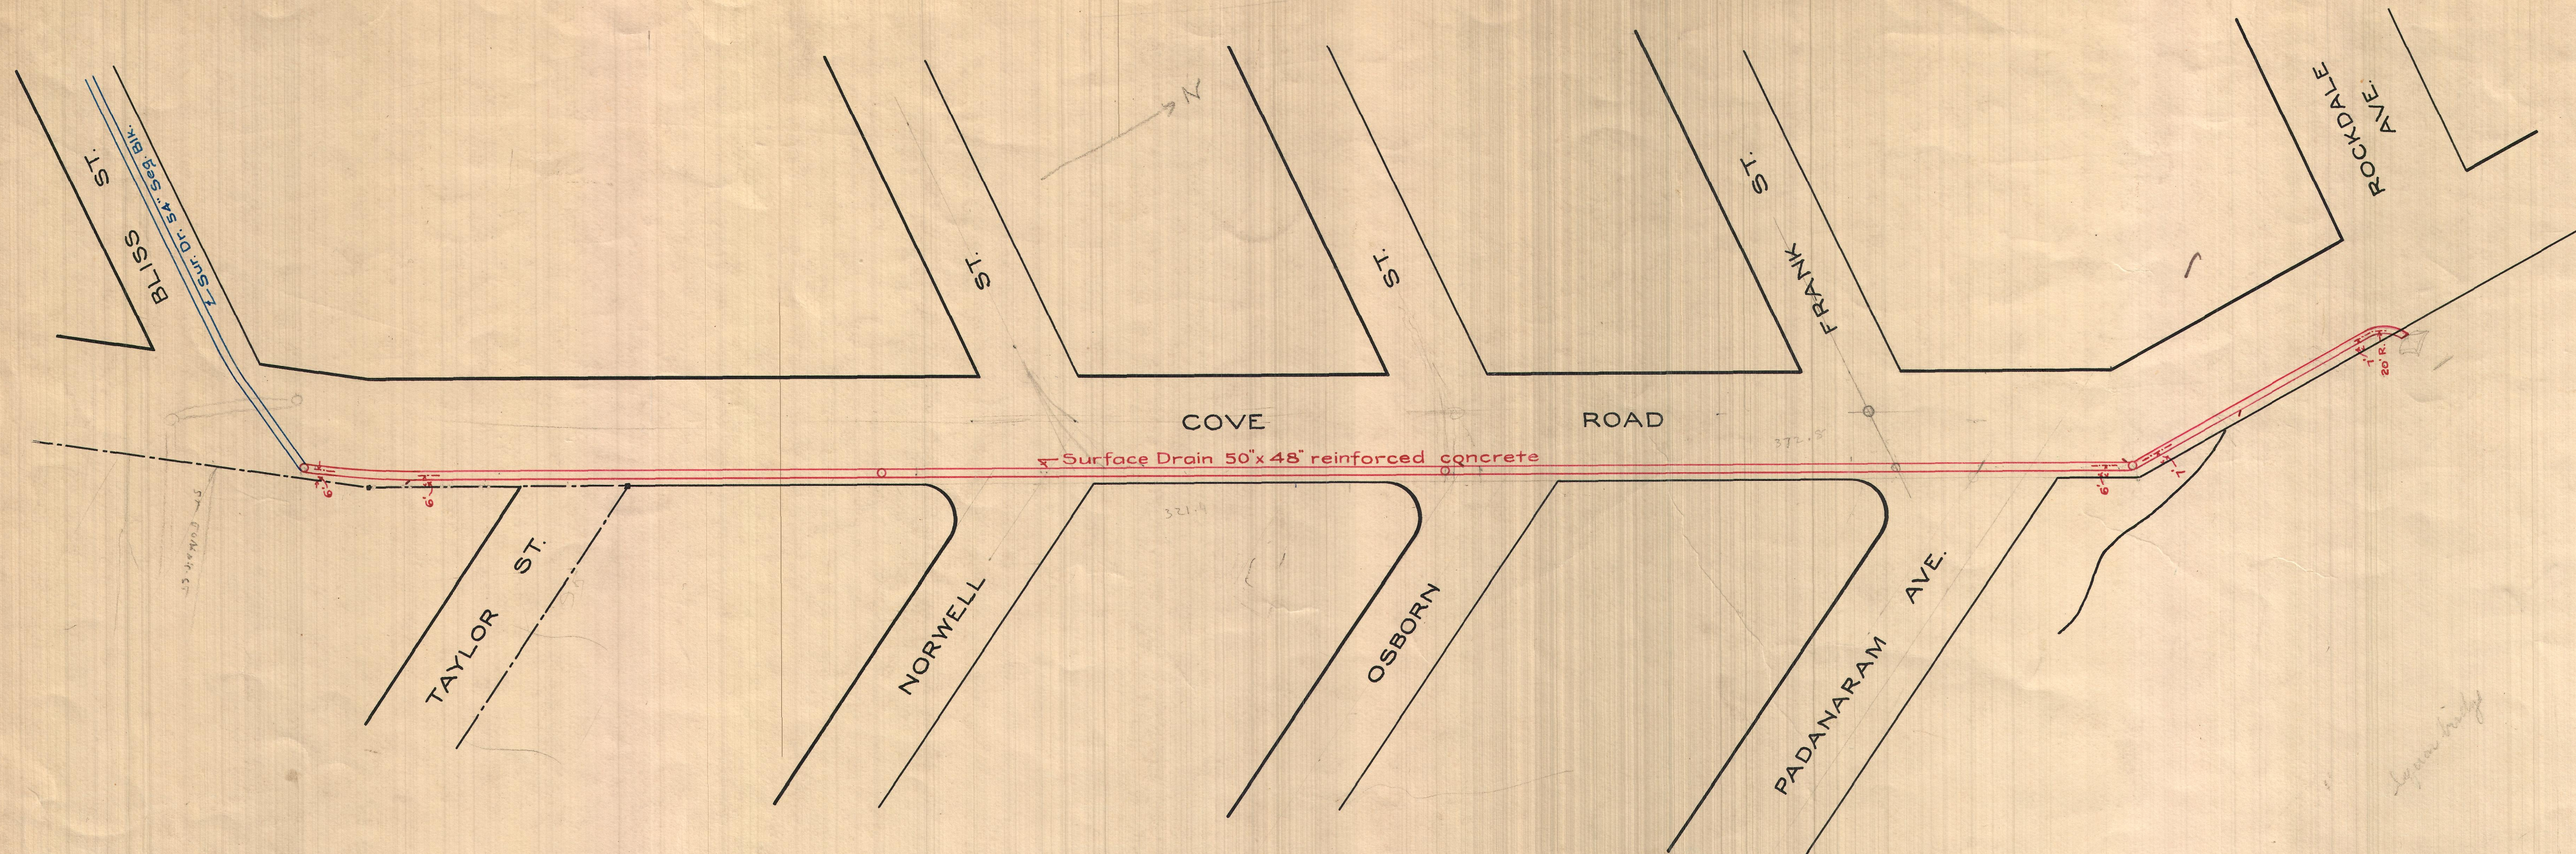

COVE ROAD SURFACE DRAIN


SCALE

Horizontal:- 1 inch = 60 feet Vertical:- 1 inch = 6 feet

BUILT UNDER W.P.A.

1942

Patricia D. Foley
COMMISSIONER

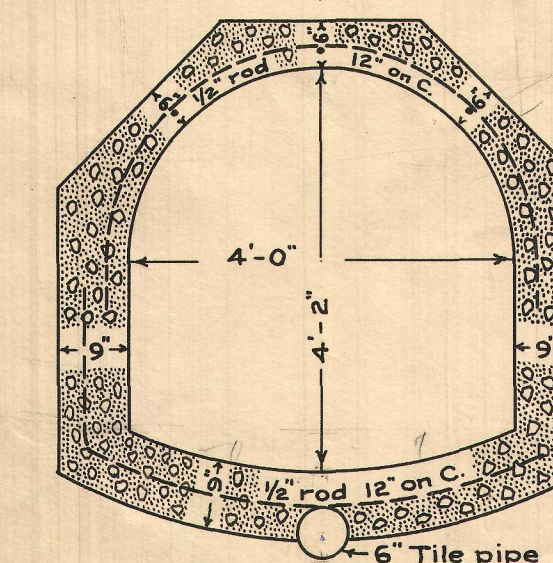

SECTION
SCALE 1"=2'

