
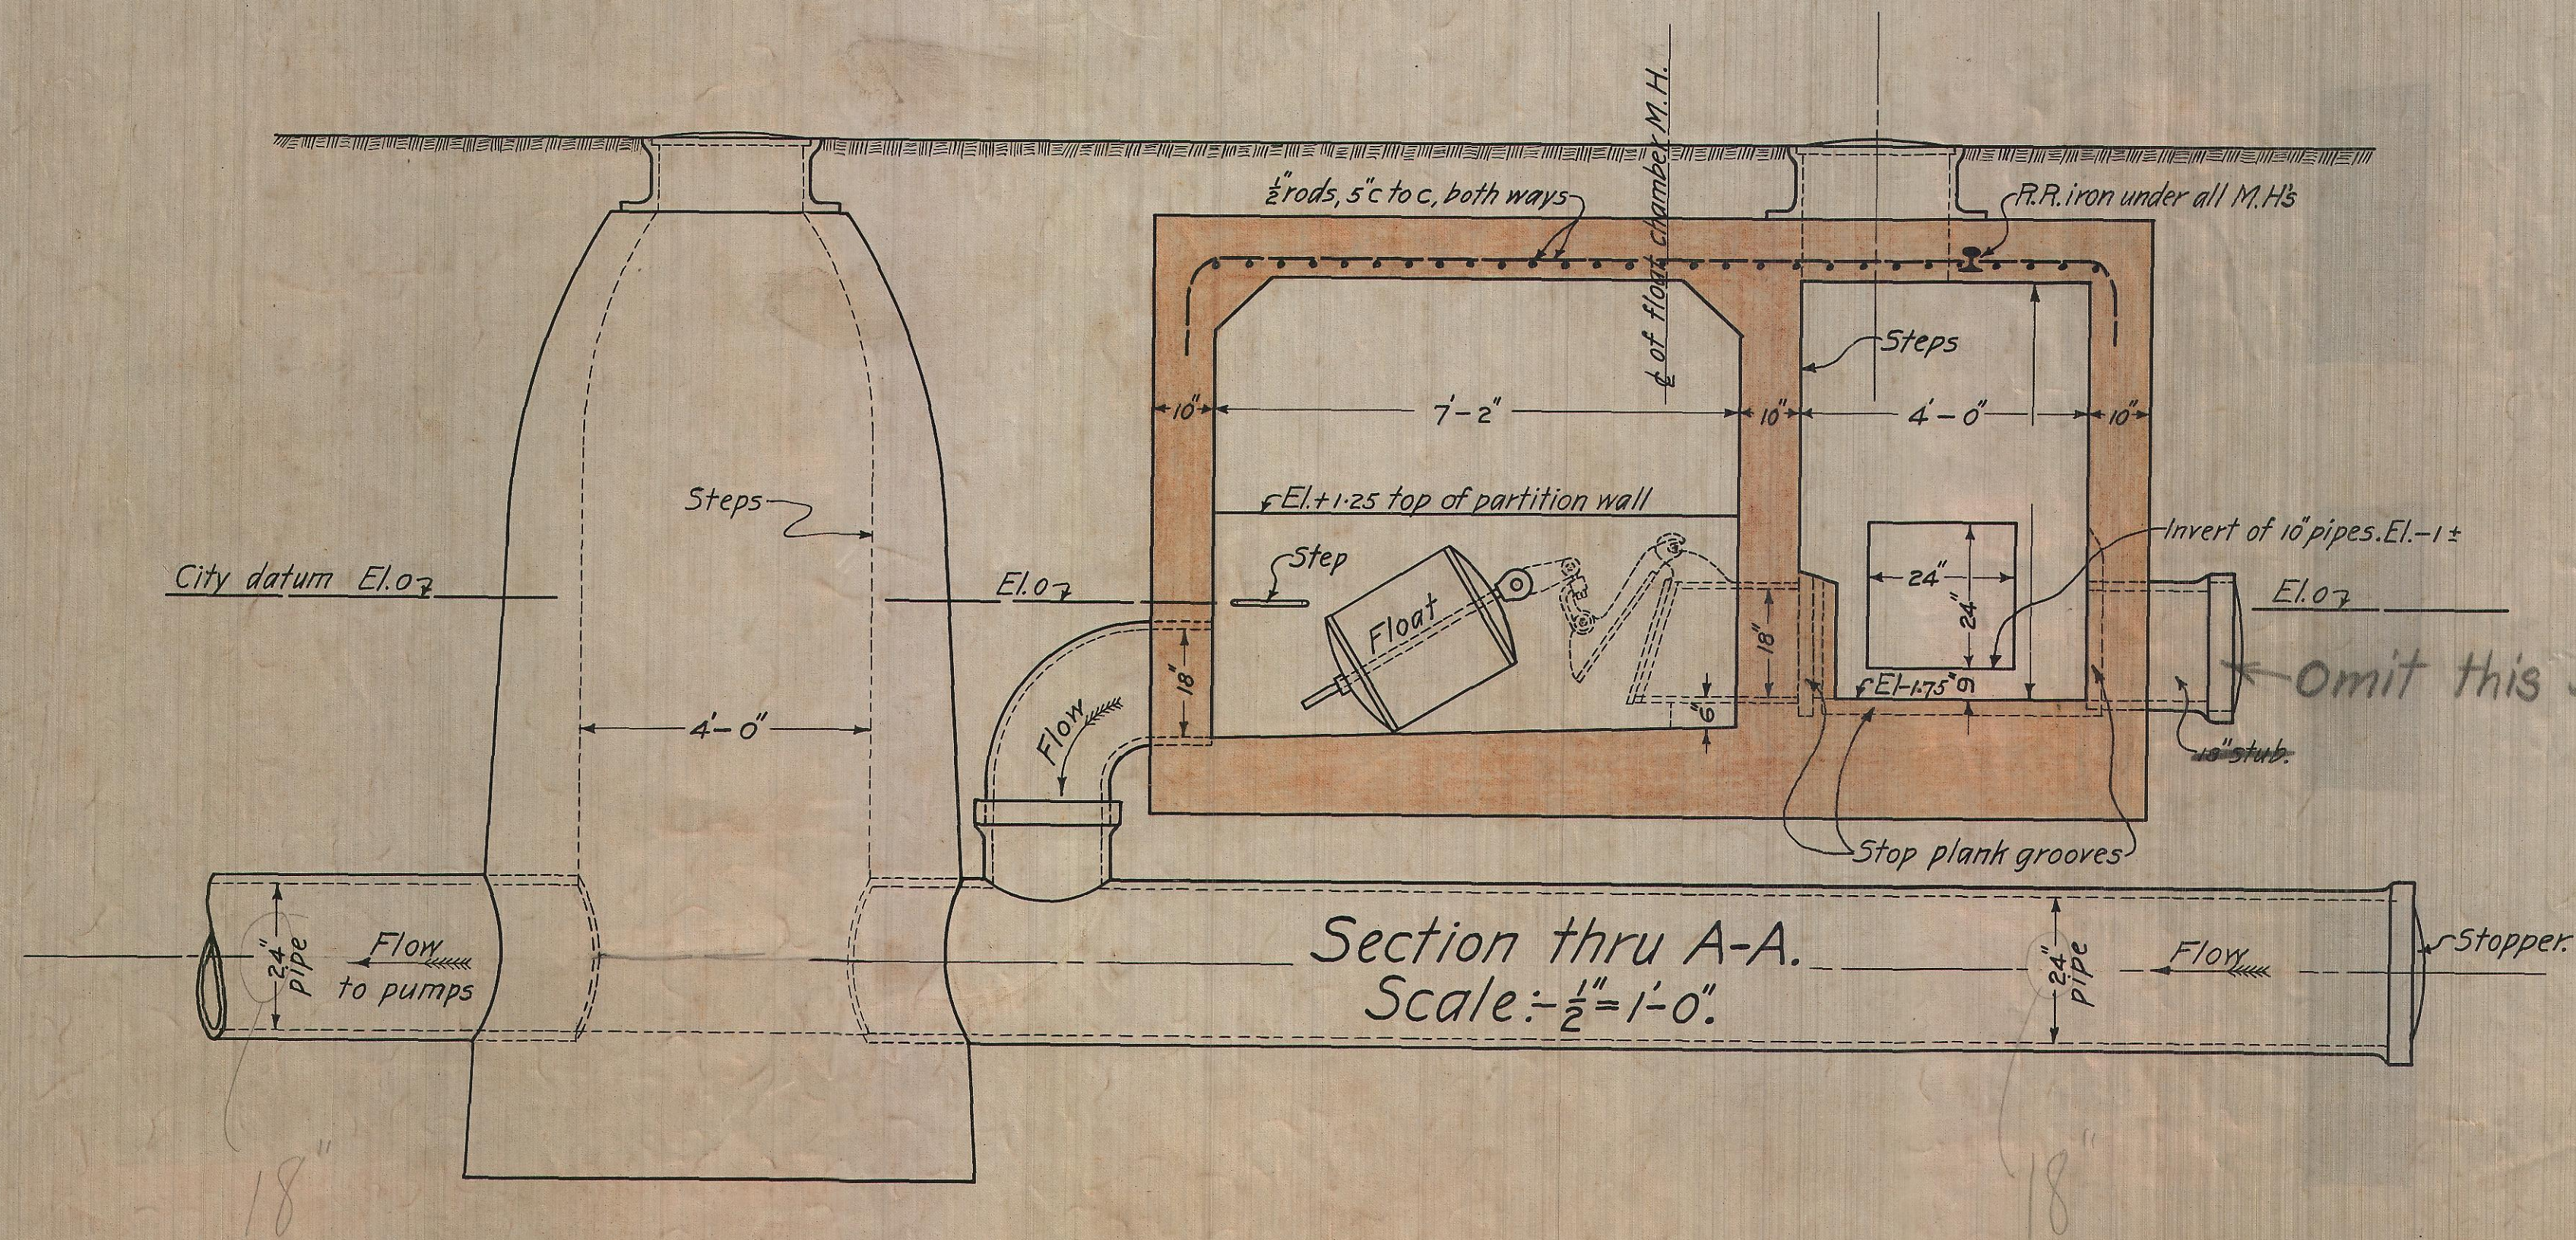


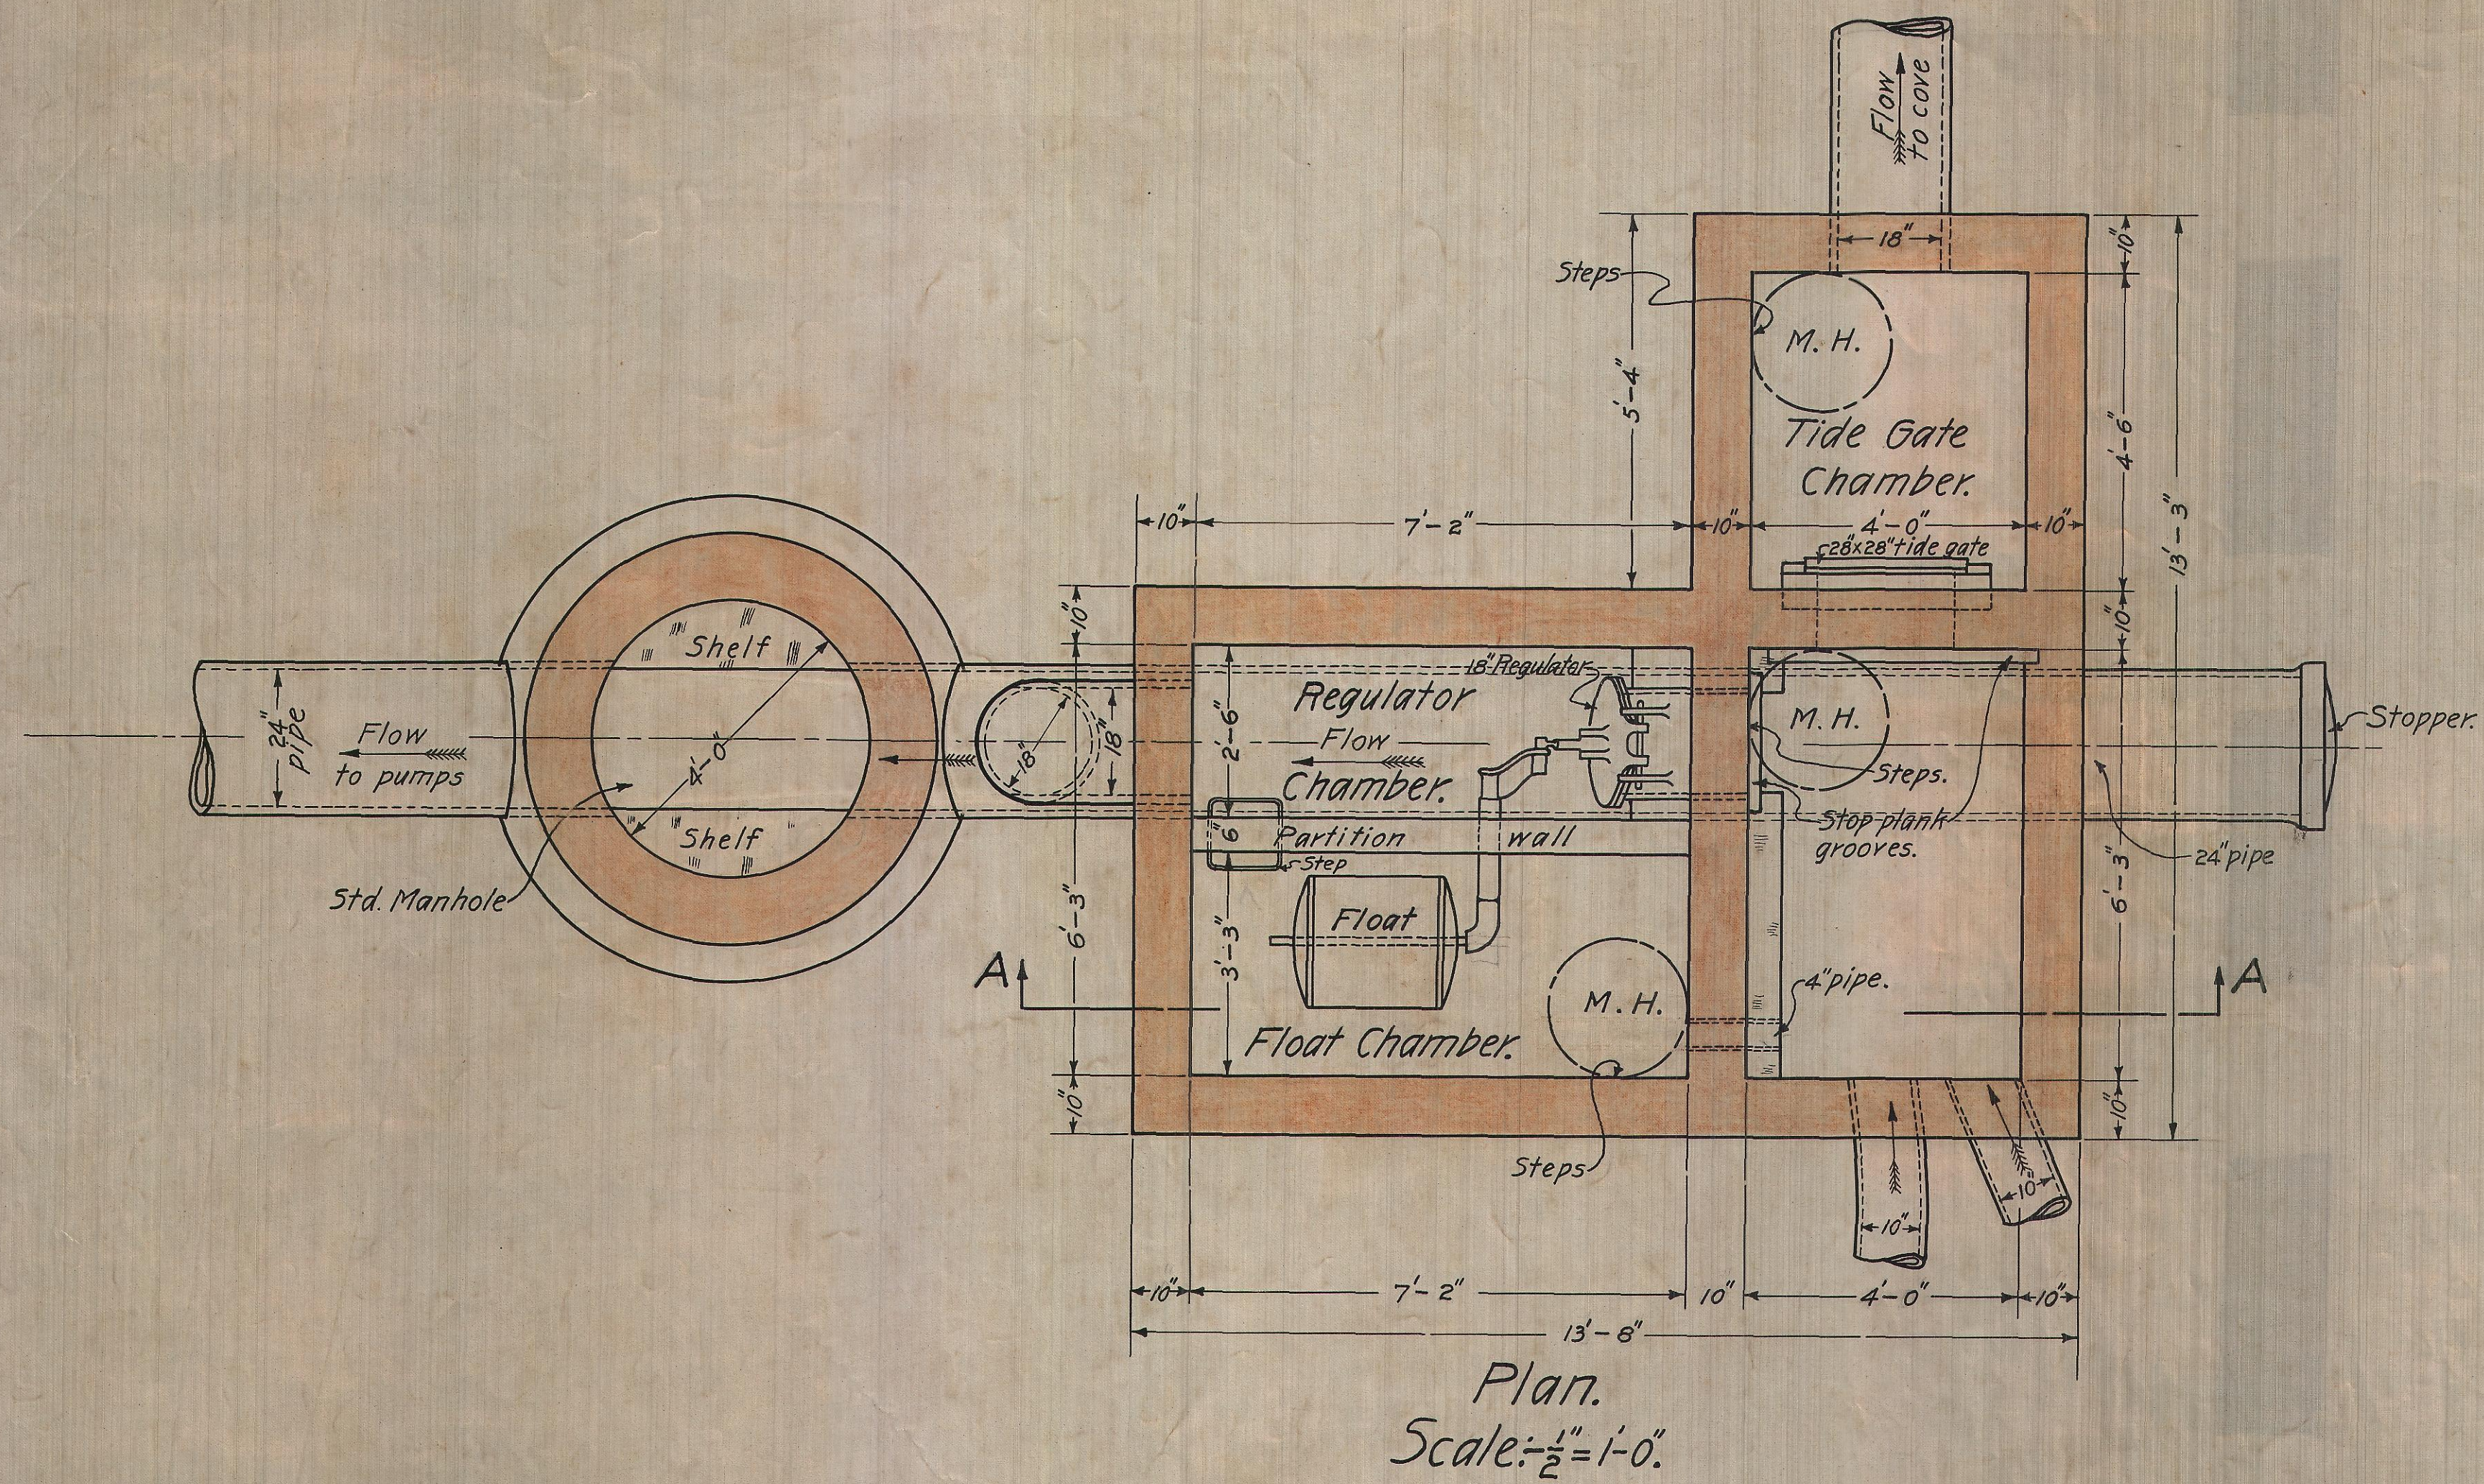

City of New Bedford
Intercepting Sewer System
LATERAL CONNECTION
Rockdale Ave. and Cove Road.

Scales as noted. August, 1914.

William F. Williams

Consulting Engineer.