

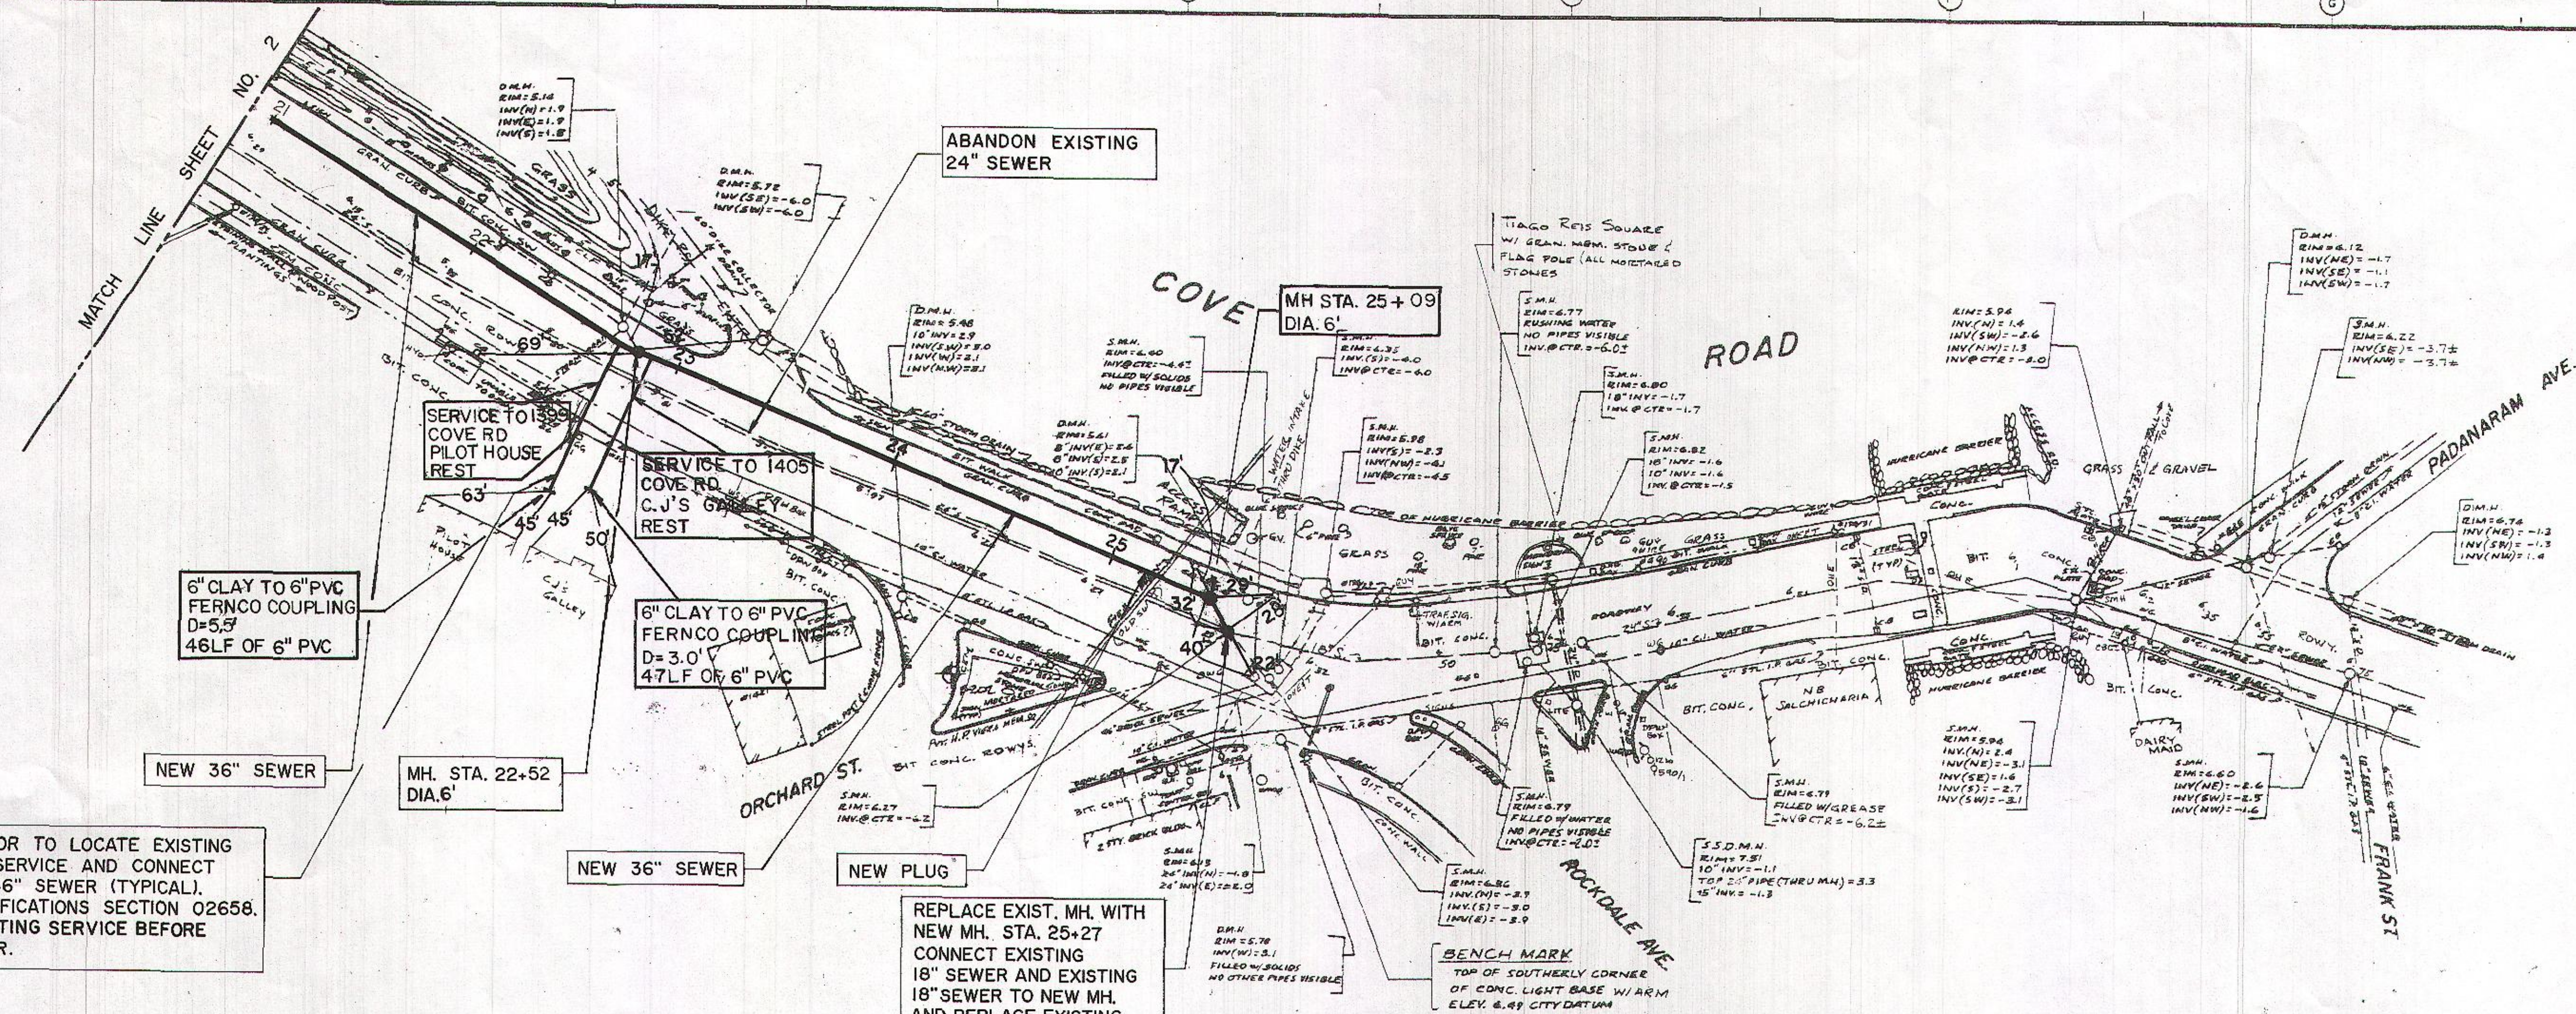


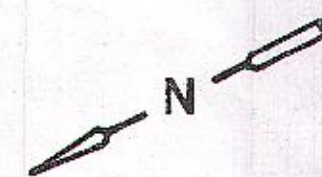


PLAN VIEW
SCALE: 1" = 40'

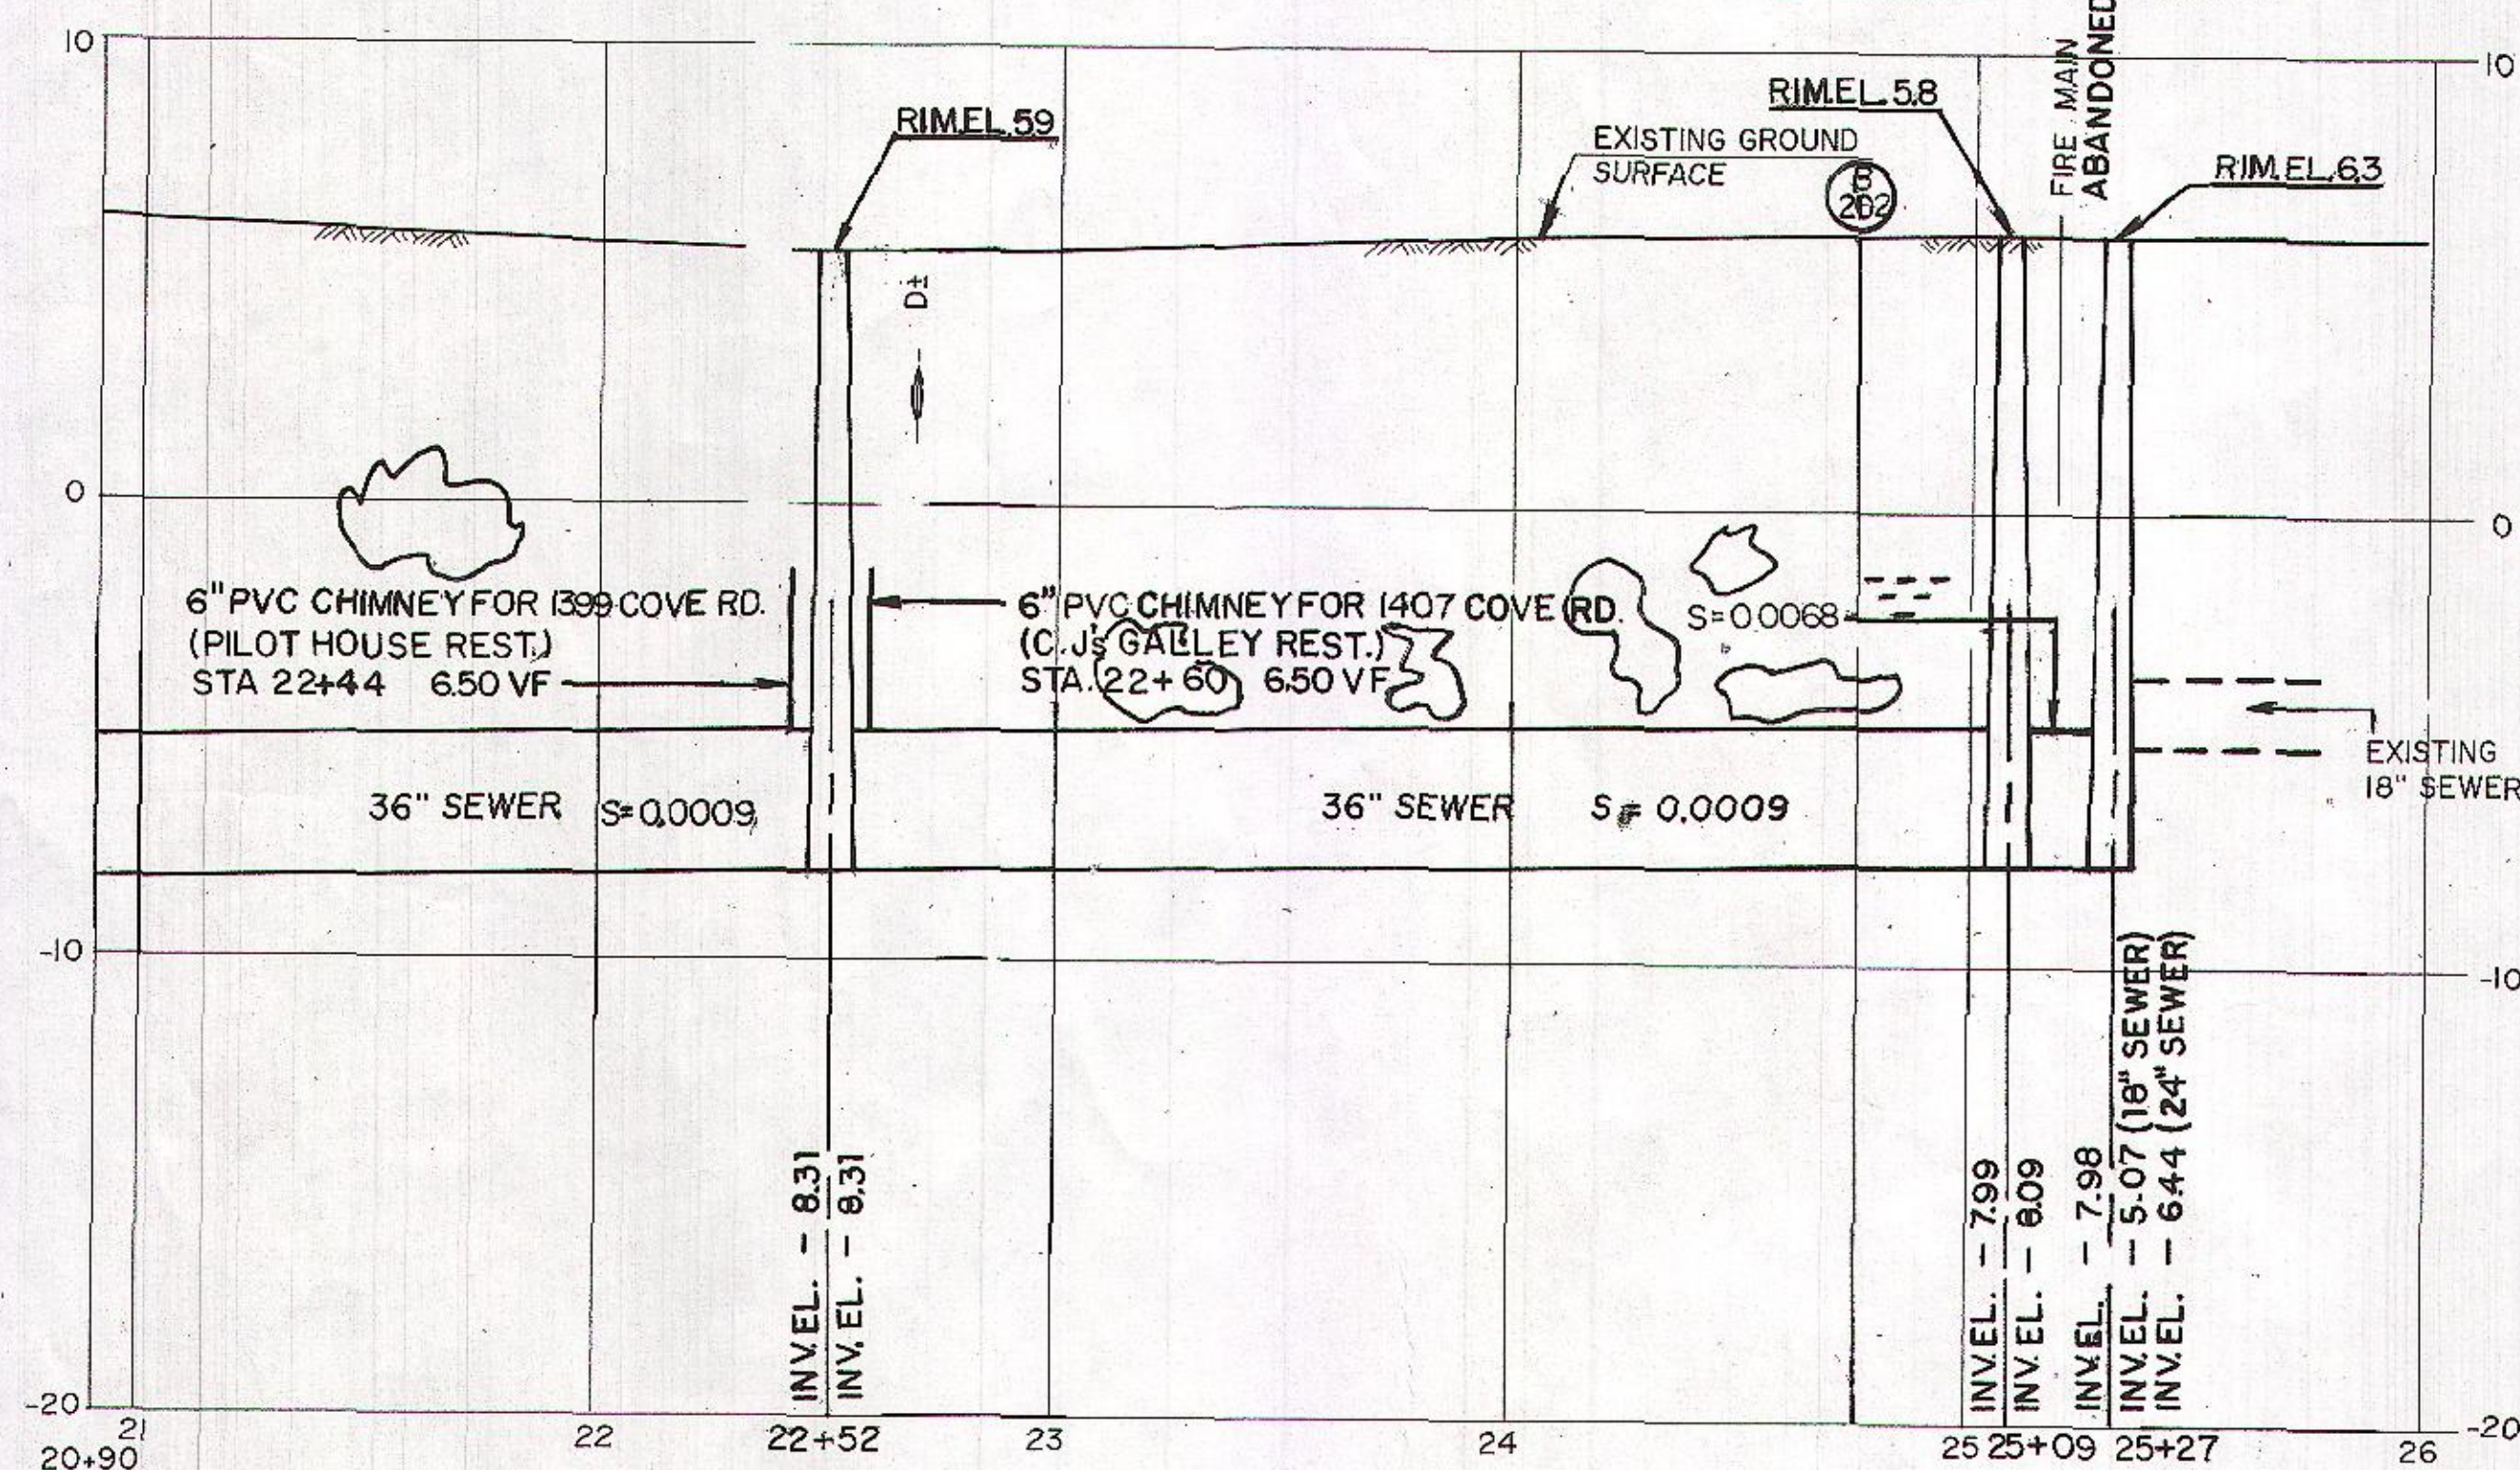


PROFILE COVE ROAD

HORIZ. 1" = 40'
VERT. 1" = 4'

RECORD DRAWING

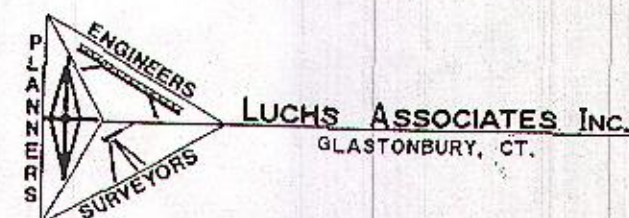

DESIGNED BY: R. JOHNSTON	CAMP DRESSER & MCKEE INC.
DRAWN BY: N. STANESCU	
SHEET CHECKED BY: J. LUCHS	
CROSS CHECKED BY: S. BEYER	
APPROVED BY: S. HICKOX	
DATE: JUNE 1995	

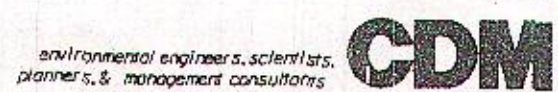

CITY OF NEW BEDFORD, MASSACHUSETTS
WASTEWATER SYSTEM IMPROVEMENTS
CONTRACT NO. 9
COVE ROAD INTERCEPTOR

COVE ROAD INTERCEPTOR



PROJECT NO.
309-49955
SHEET NO.
3