



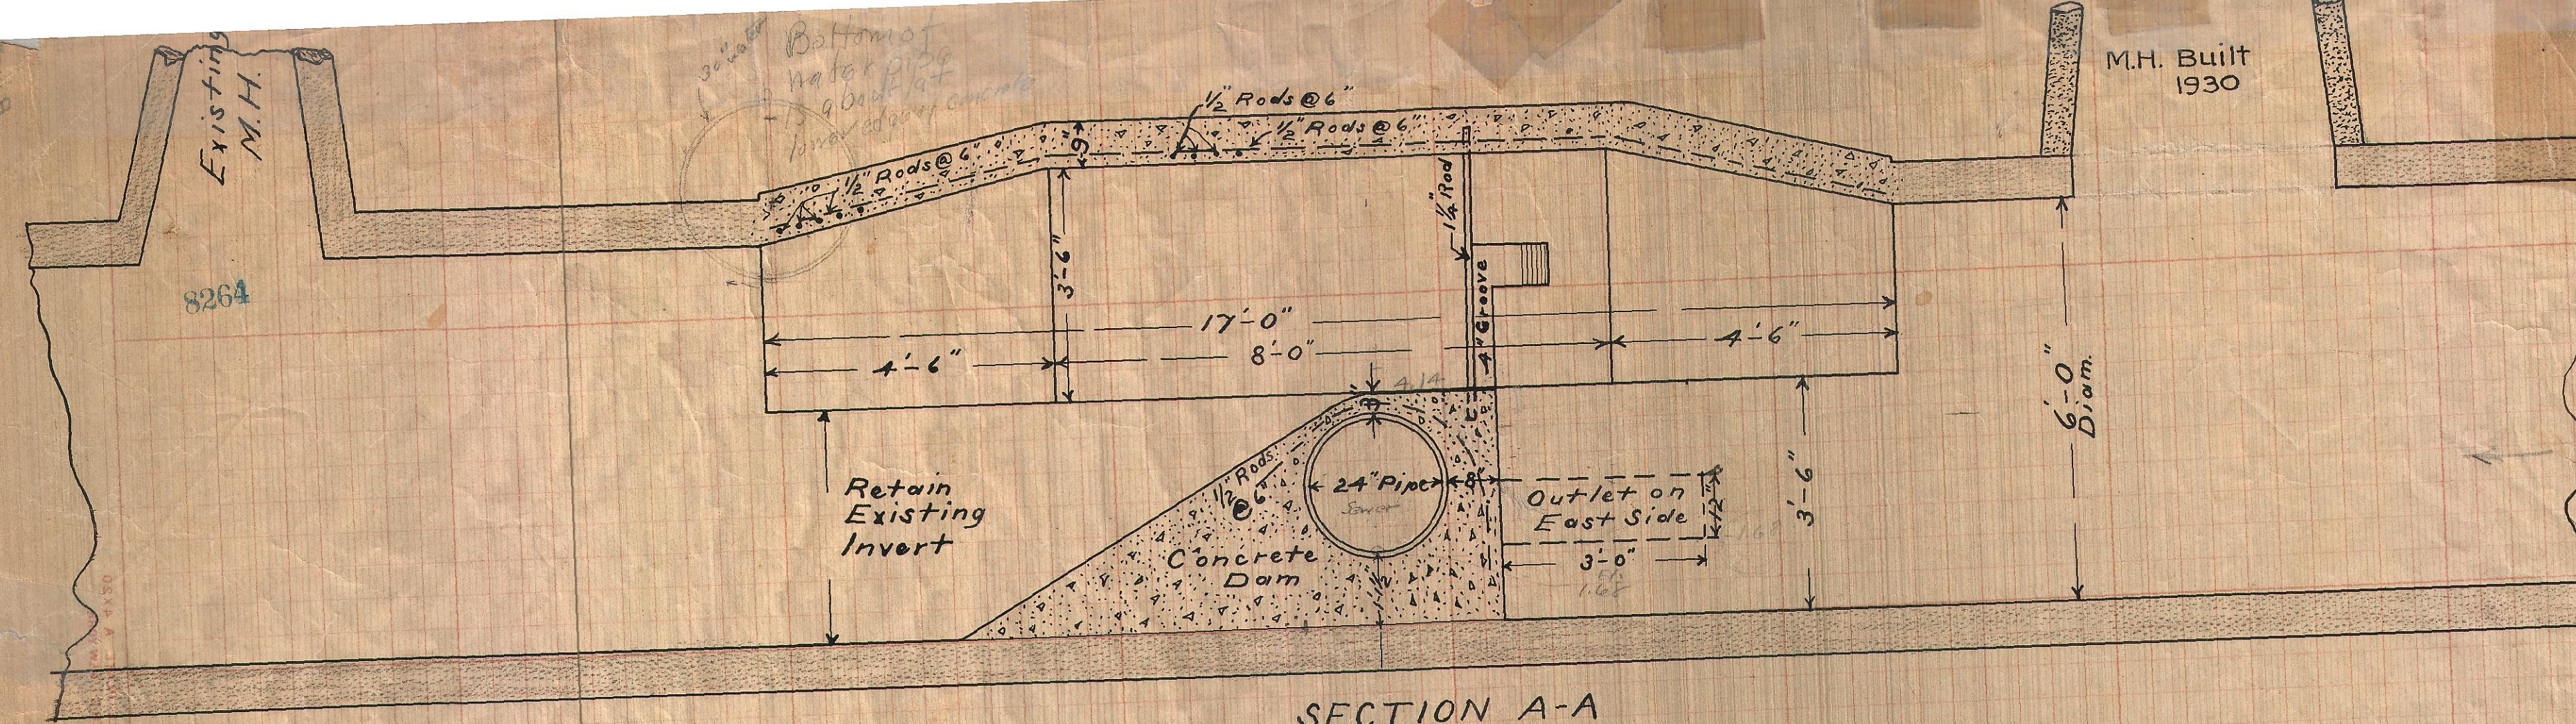

SECTION A-A

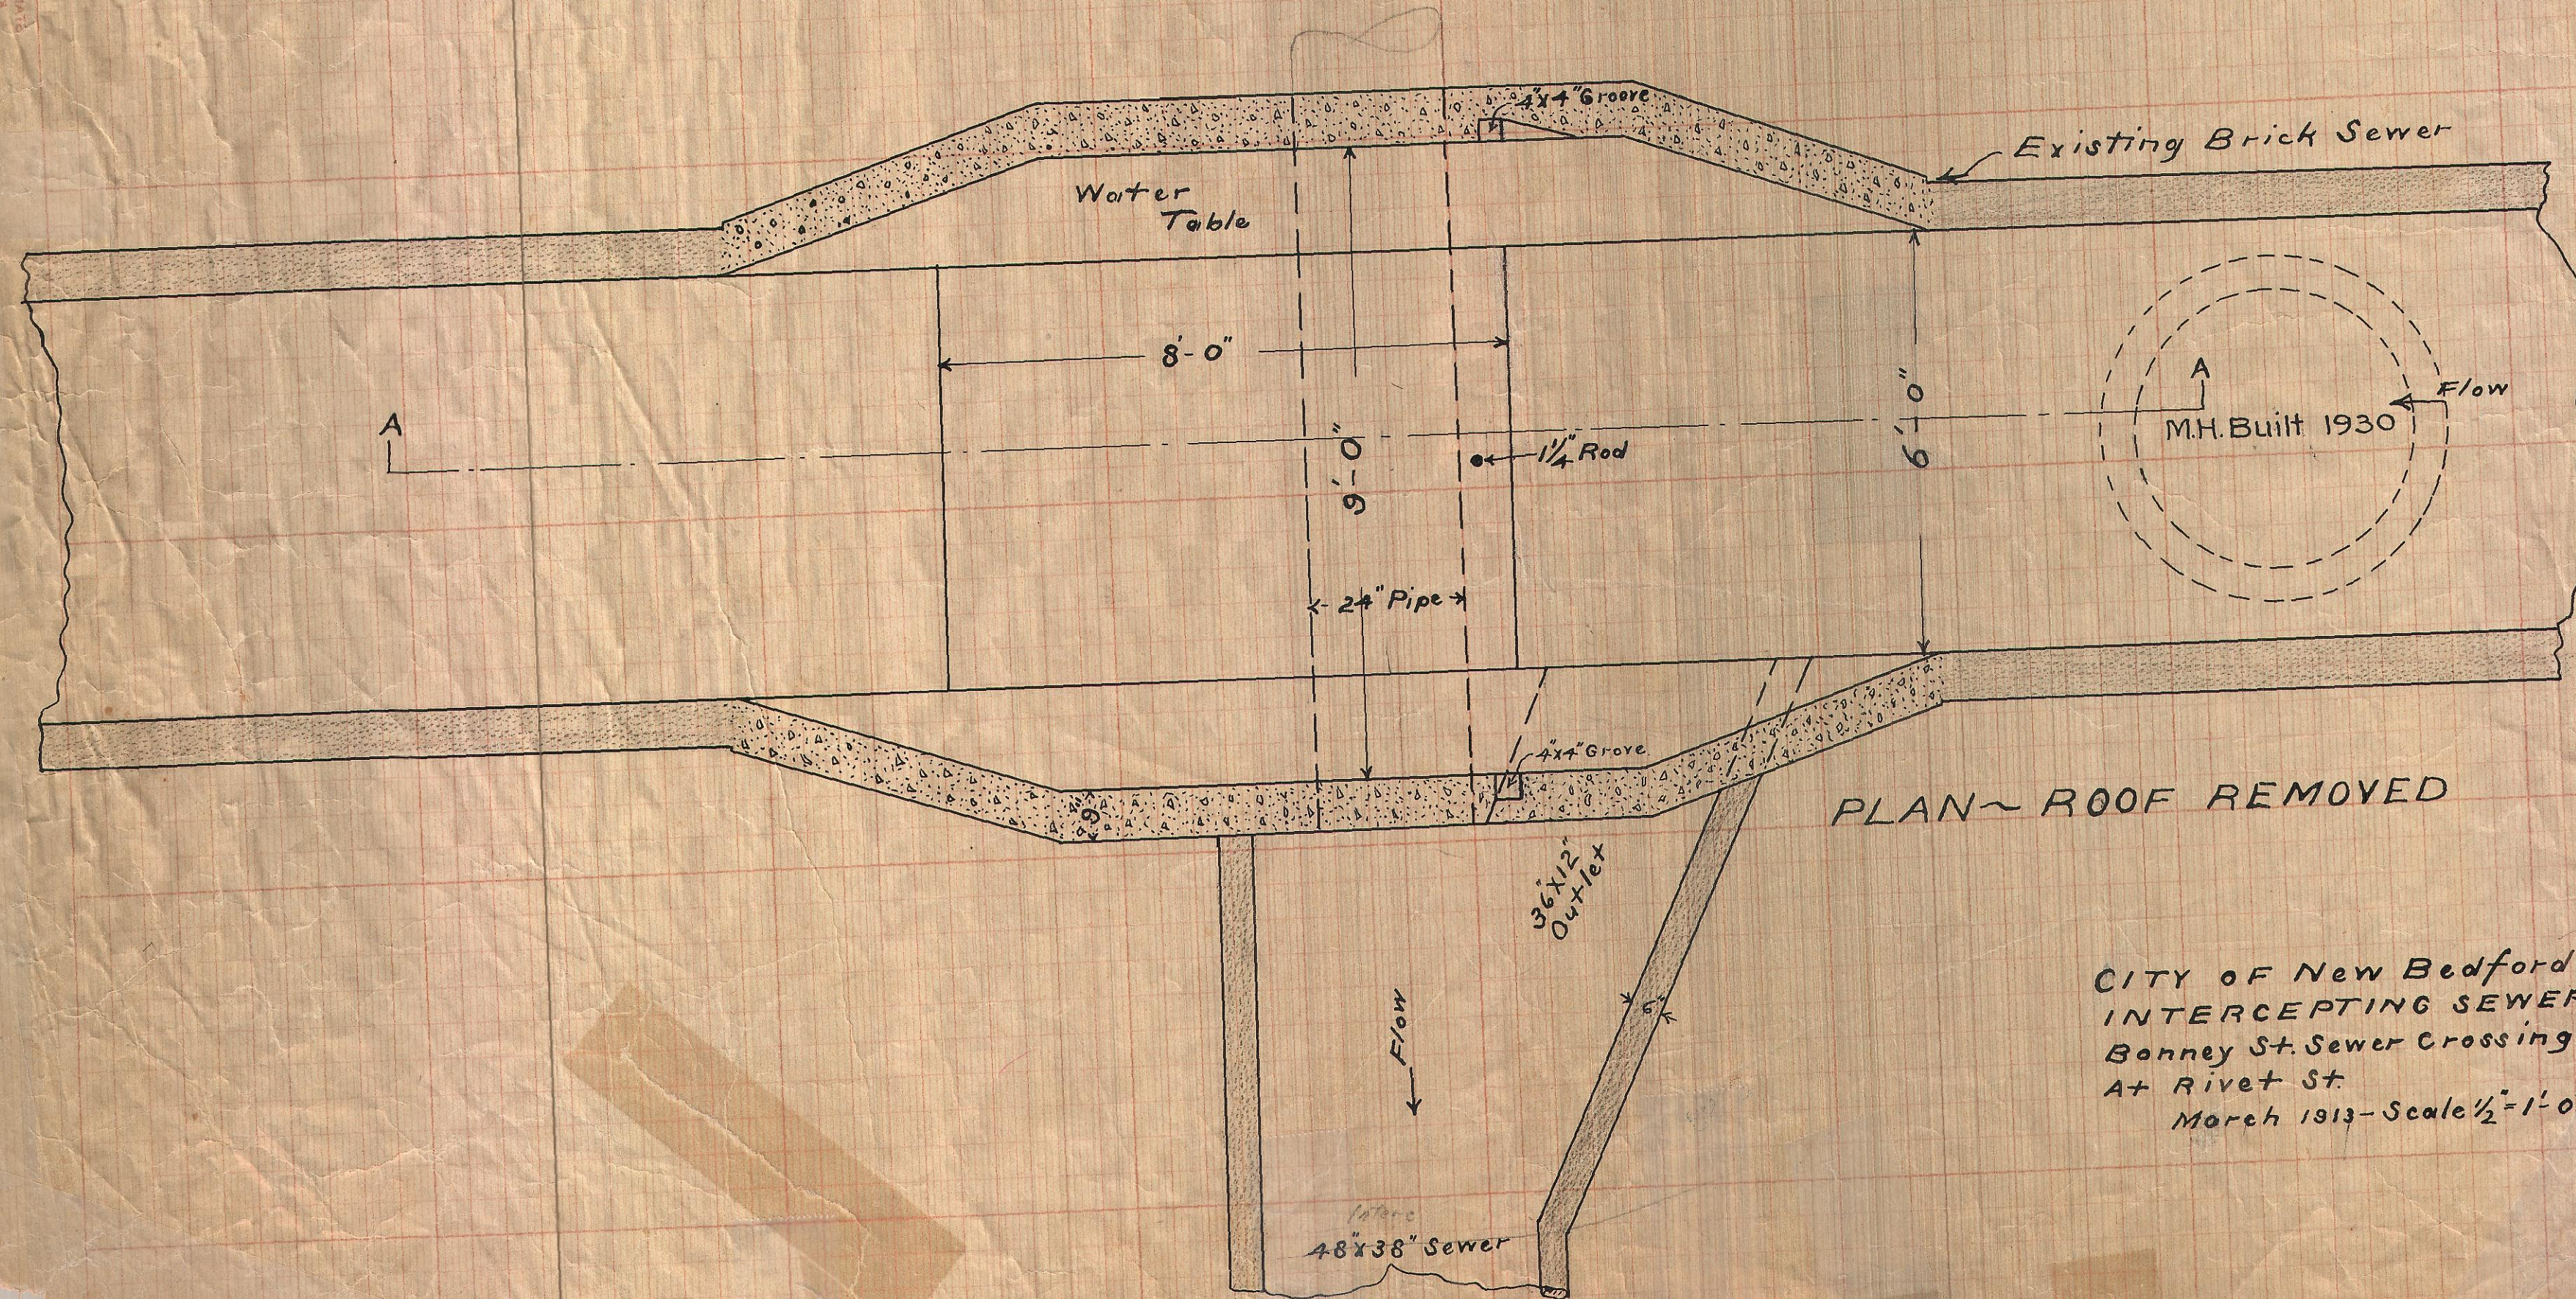

CITY OF New Bedford
INTERCEPTING SEWER
Bonney St. Sewer Crossing
At River St.
March 1913 - Scale $\frac{1}{2}$ " = 1'-0"