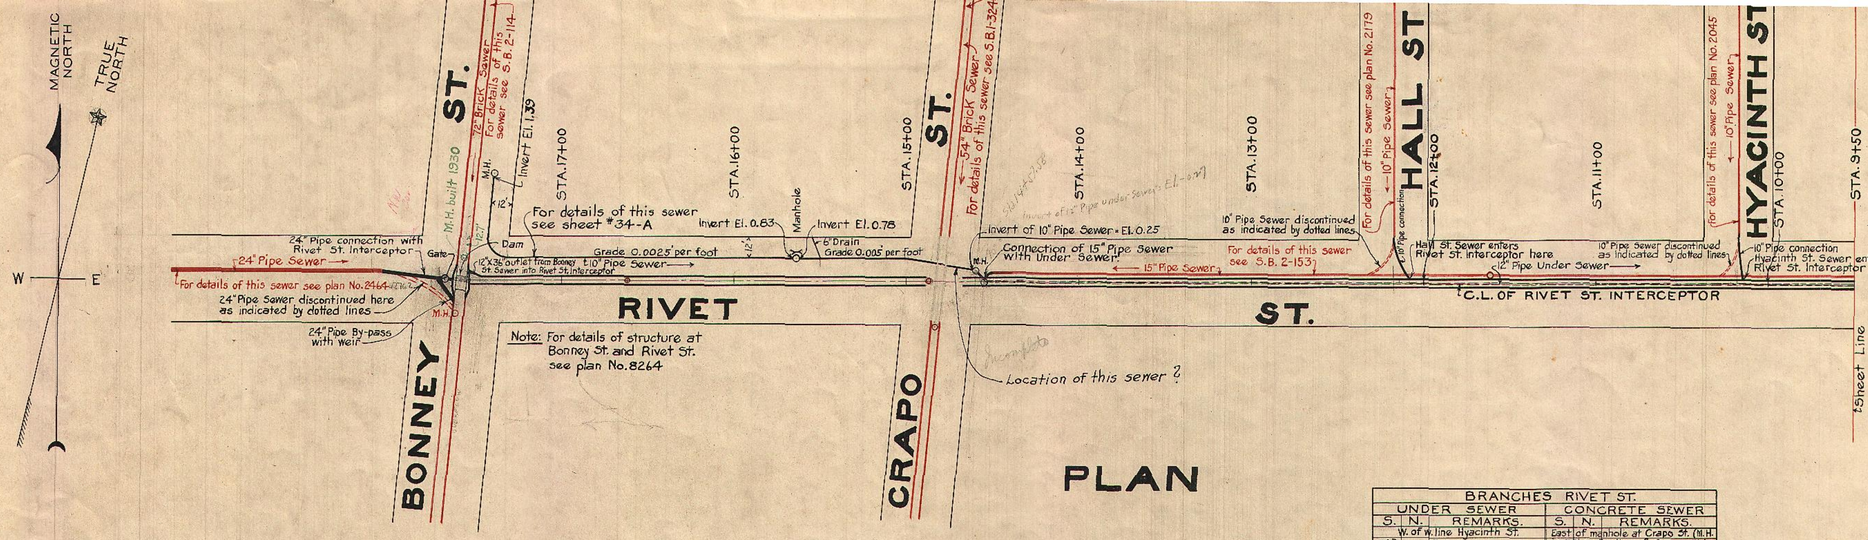

PLAN

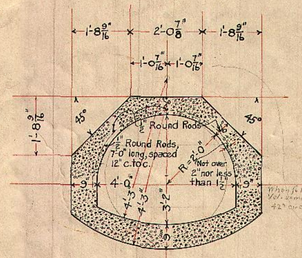

SECTION OF 3'-2" X 4'-0" REINFORCED CONCRETE SEWER
CRAPO ST. – BONNEY ST.
SCALE 1/2" = 1'

AUTHORITY OF CHAP. 474, ACTS OF 1910.

SEWAGE DISPOSAL
NEW BEDFORD, MASS.
INTERCEPTING SEWER
RIVET ST. INTERCEPTOR
STA. 9+50 – BONNEY ST.

SCALES: PLAN 1" = 40'
PROFILE: Hor. 1" = 40' Ver. 1" = 4'
SEPT. 1920.

BRANCHES RIVET ST.					
UNDER SEWER			CONCRETE SEWER		
S.	N.	REMARKS.	S.	N.	REMARKS.
		W. of w. line Hyacinth St.	East of manhole at Crapo St. (M.H.		
32.7		Ent.	15.5	2. of e. line of Crapo St.)	
70.5		Ent.		44.0	10" El. 3.1 Entered by
115.0		Ent.			Hyacinth St. Sewer.
146.5		Ent.	433.0		6" El. 2.7
	W. of	e. line Hall St.	583.3		6" El. 3.0
	11.3	10"	347.0		6" El. 3.4
37.0		Ent.	302.5		6" El. 3.4
	W. of	w. line Hall St.	272.0		6" El. 3.3
16.7		Ent.		246.6	10" El. 3.3 Entered by
77.7		Ent.			Hall St. Sewer
115.1		Ent.	200.2		6" El. 3.4
120.2		Ent.	138.8		6" El. 3.1
	At s. line Crapo St.	12" x 12"	102.2		6" El. 4.0
			46.7		6" El. 3.2
10" PIPE SEWER		(In Rivet St. and e. line of Crapo St.)			
	E. of	w. line Crapo St.			
	26.6				
	10.7				
	W. of	w. line Crapo St.			
	10.0				
	51.2				
68.0		Manhole			
	N. of	N. line Rivet St.			
37.0		Manhole			

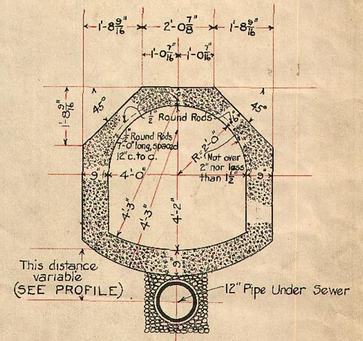

SECTION OF 4'-2" X 4'-0" REINFORCED CONCRETE SEWER
STA. 9+50 – CRAPO ST.
SCALE 1/2" = 1'

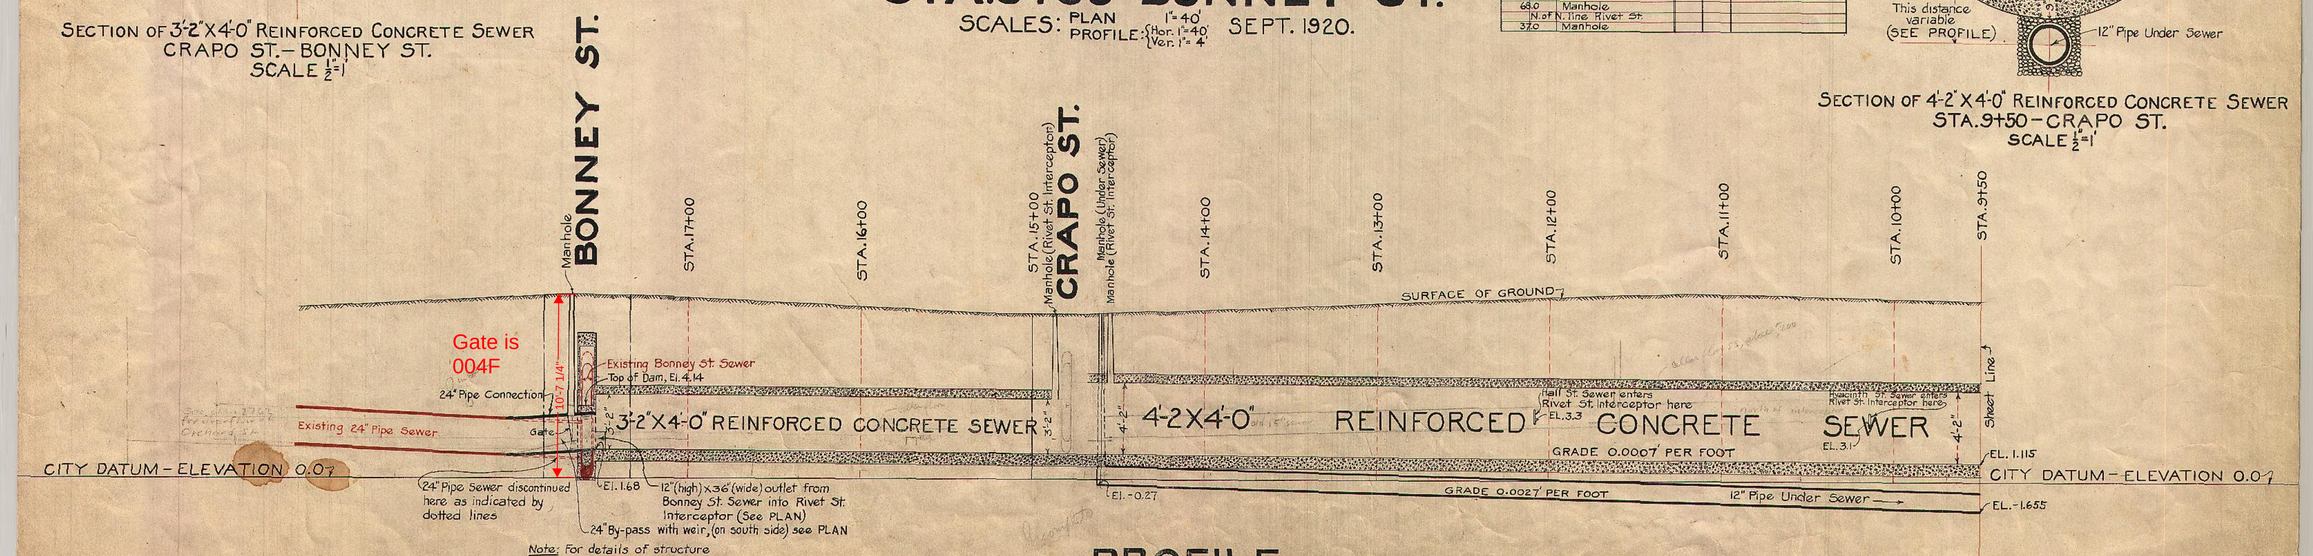

PROFILE

SHEET 34 OF 48

