


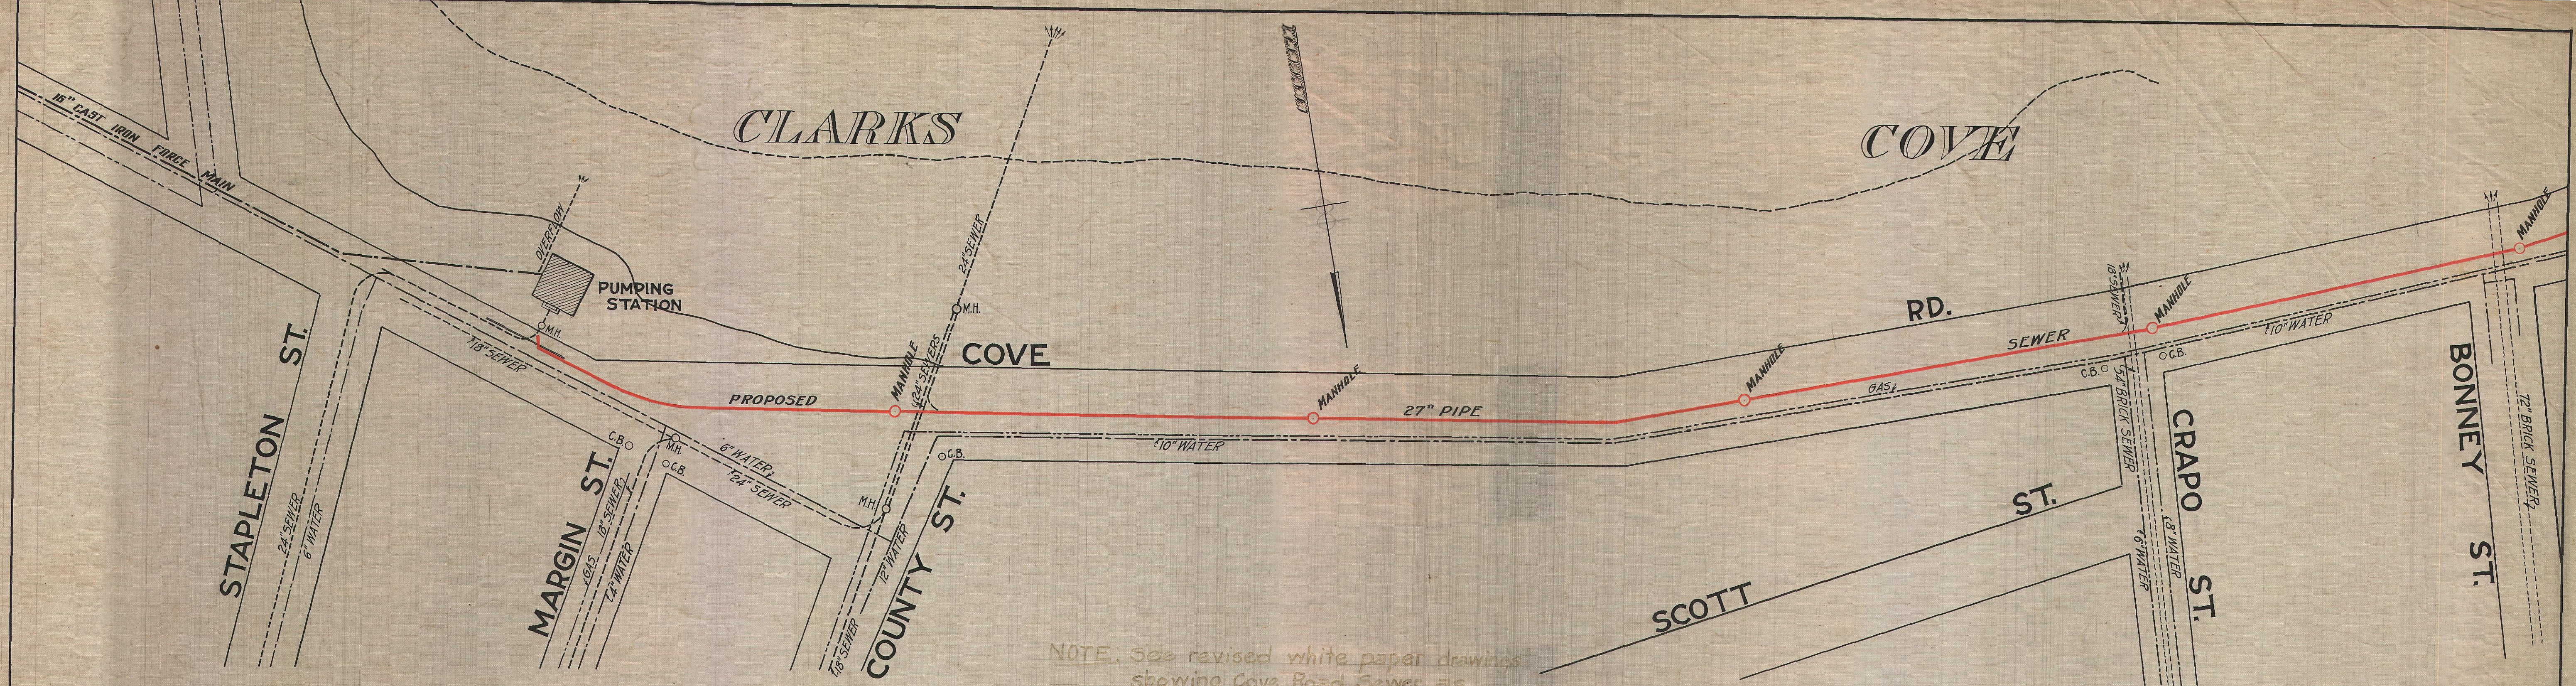

NOTE: See revised white paper drawings showing Cove Road Sewer as constructed.

City of New Bedford
 Intercepting Sewer System
 Cove Road Sewer
 To
 Pumping Station

Note:- Place 6" branches for house connections.

Scales { Hor. lin. = 60 ft.
 Vert. " " 6 " April, 1914

William F. Williams
 Consulting Engineer

