
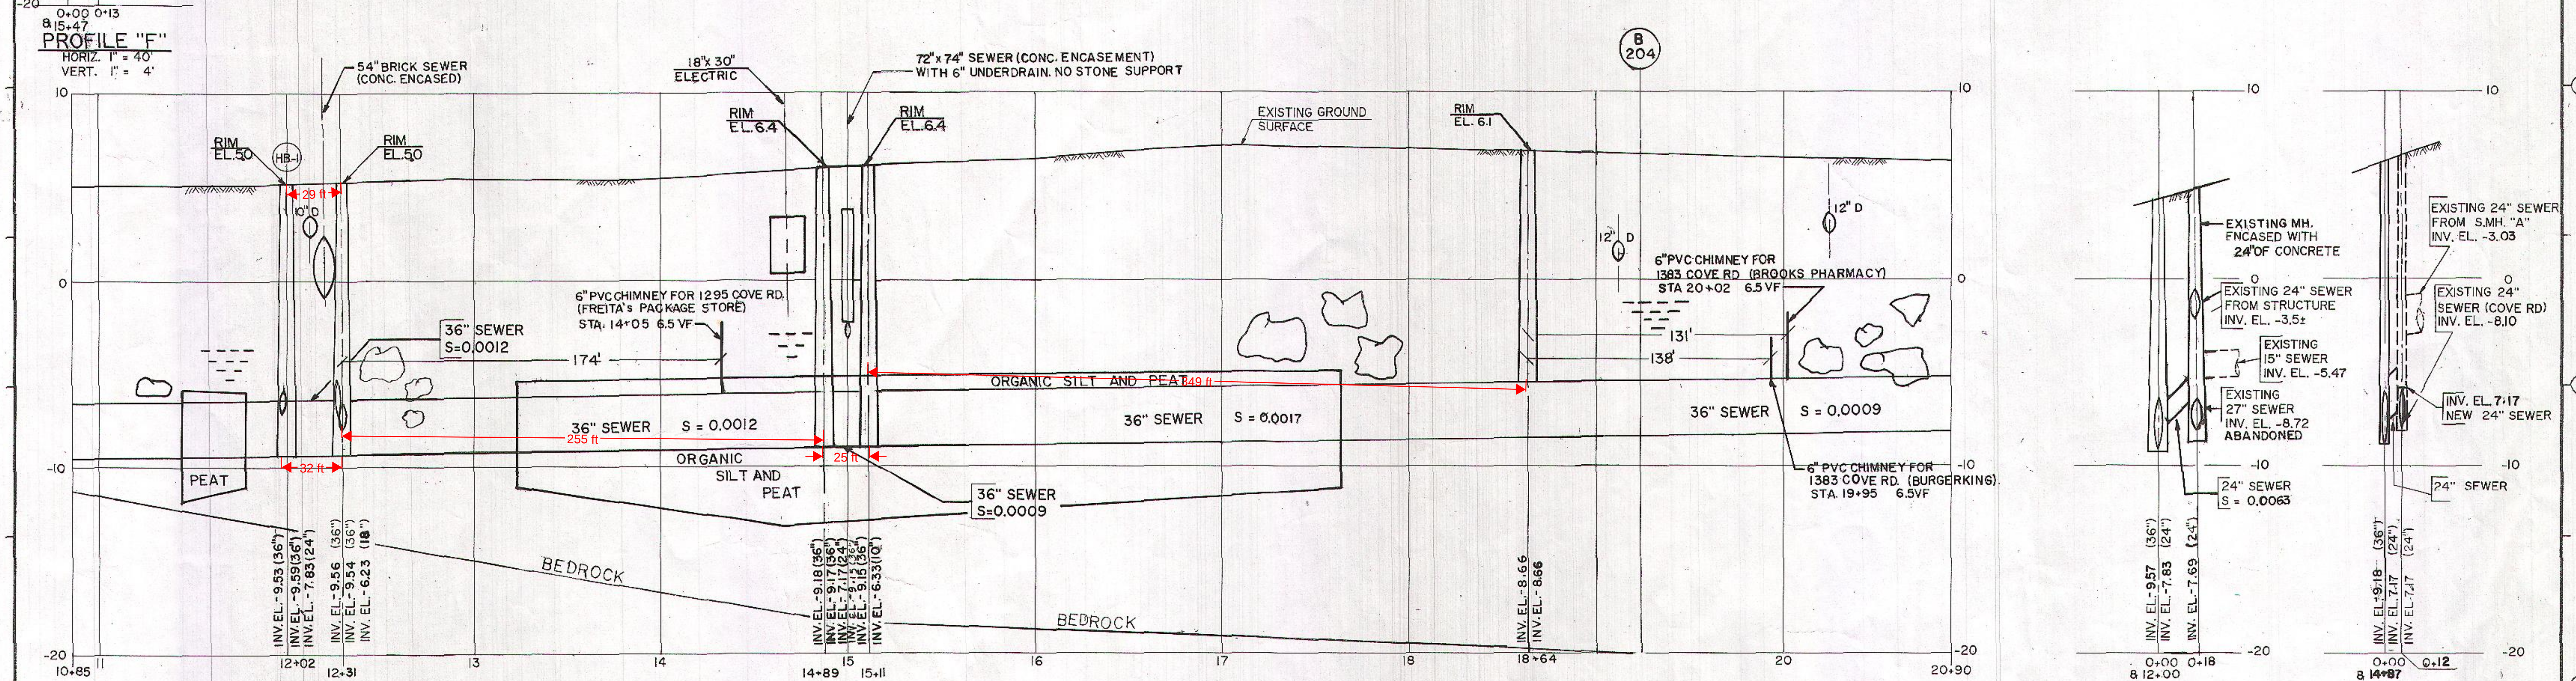


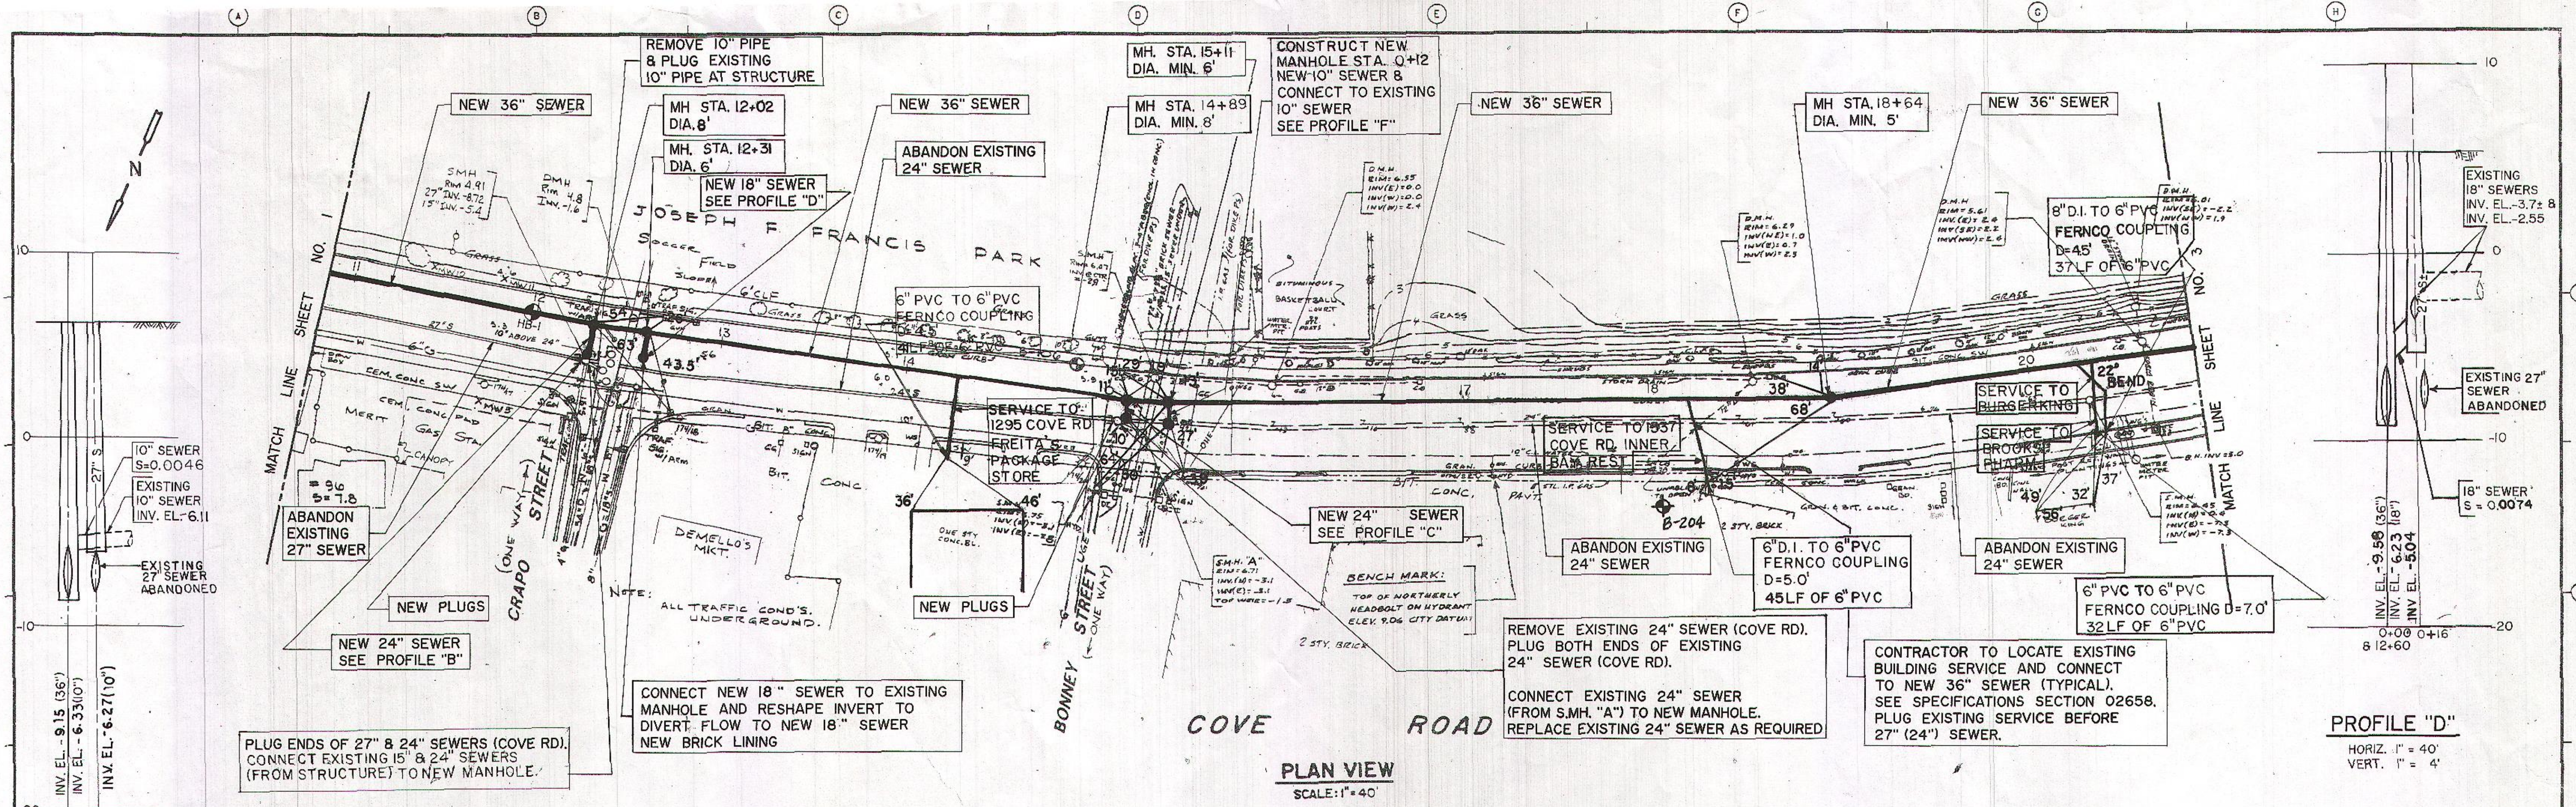

ENGINEERS
SURVEYORS

LUCHS ASSOCIATES INC.
GLASTONBURY, CT.

DESIGNED BY: **R. JOHNSTON**

DRAWN BY: **N. STANESCU**

SHEET CHECKED BY: **J. LUCHS**

CROSS CHECKED BY: **S. BEYER**

APPROVED BY: **S. HICKOX**

DATE: **JUNE 1995**

CAMP DRESSER & MCKEE INC.

environmental engineers, scientists,
planners & management consultants

CDM

CITY OF NEW BEDFORD, MASSACHUSETTS

WASTEWATER SYSTEM IMPROVEMENTS

CONTRACT NO. 9

COVE ROAD INTERCEPTOR

COVE ROAD INTERCEPTOR

PROJECT NO.
309 - 49954

SHEET NO.
2