2295



DAVID STREET SEWER

FROM CLARKS COVE TO BROCK AVENUE.

LENGTH

490.7 feet of glazed pipe 12 inches in diameter
575.3 " " " " 10 " " "
1066.0


SCALE

Horizontal 1 inch = 60 feet. Vertical 1 inch = 6 feet

Ordered	May 7, 1901
Constuction Commenced	June 24, 1901
Average Depth	6.42 Feet
Ledge Excavated	None
Cost	$ 1496.63
Amount Assessed	748.31
Foreman	Martin Ryan

Field-book 107 ppge 65

William F. Williams
CITY ENGINEER.

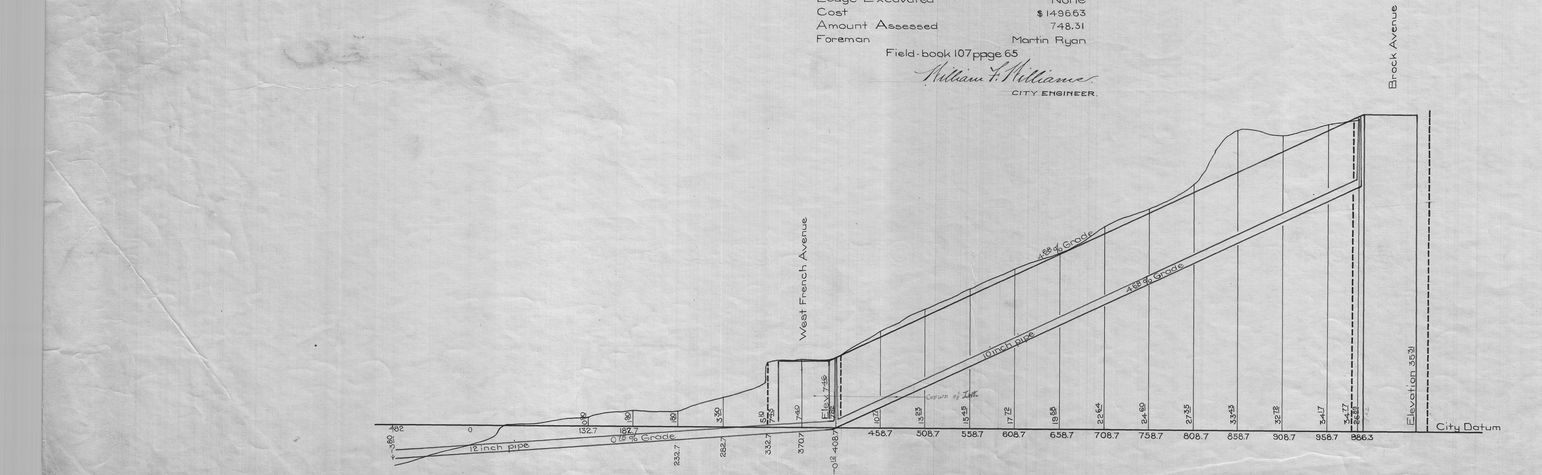

2295