


CLARKS COVE

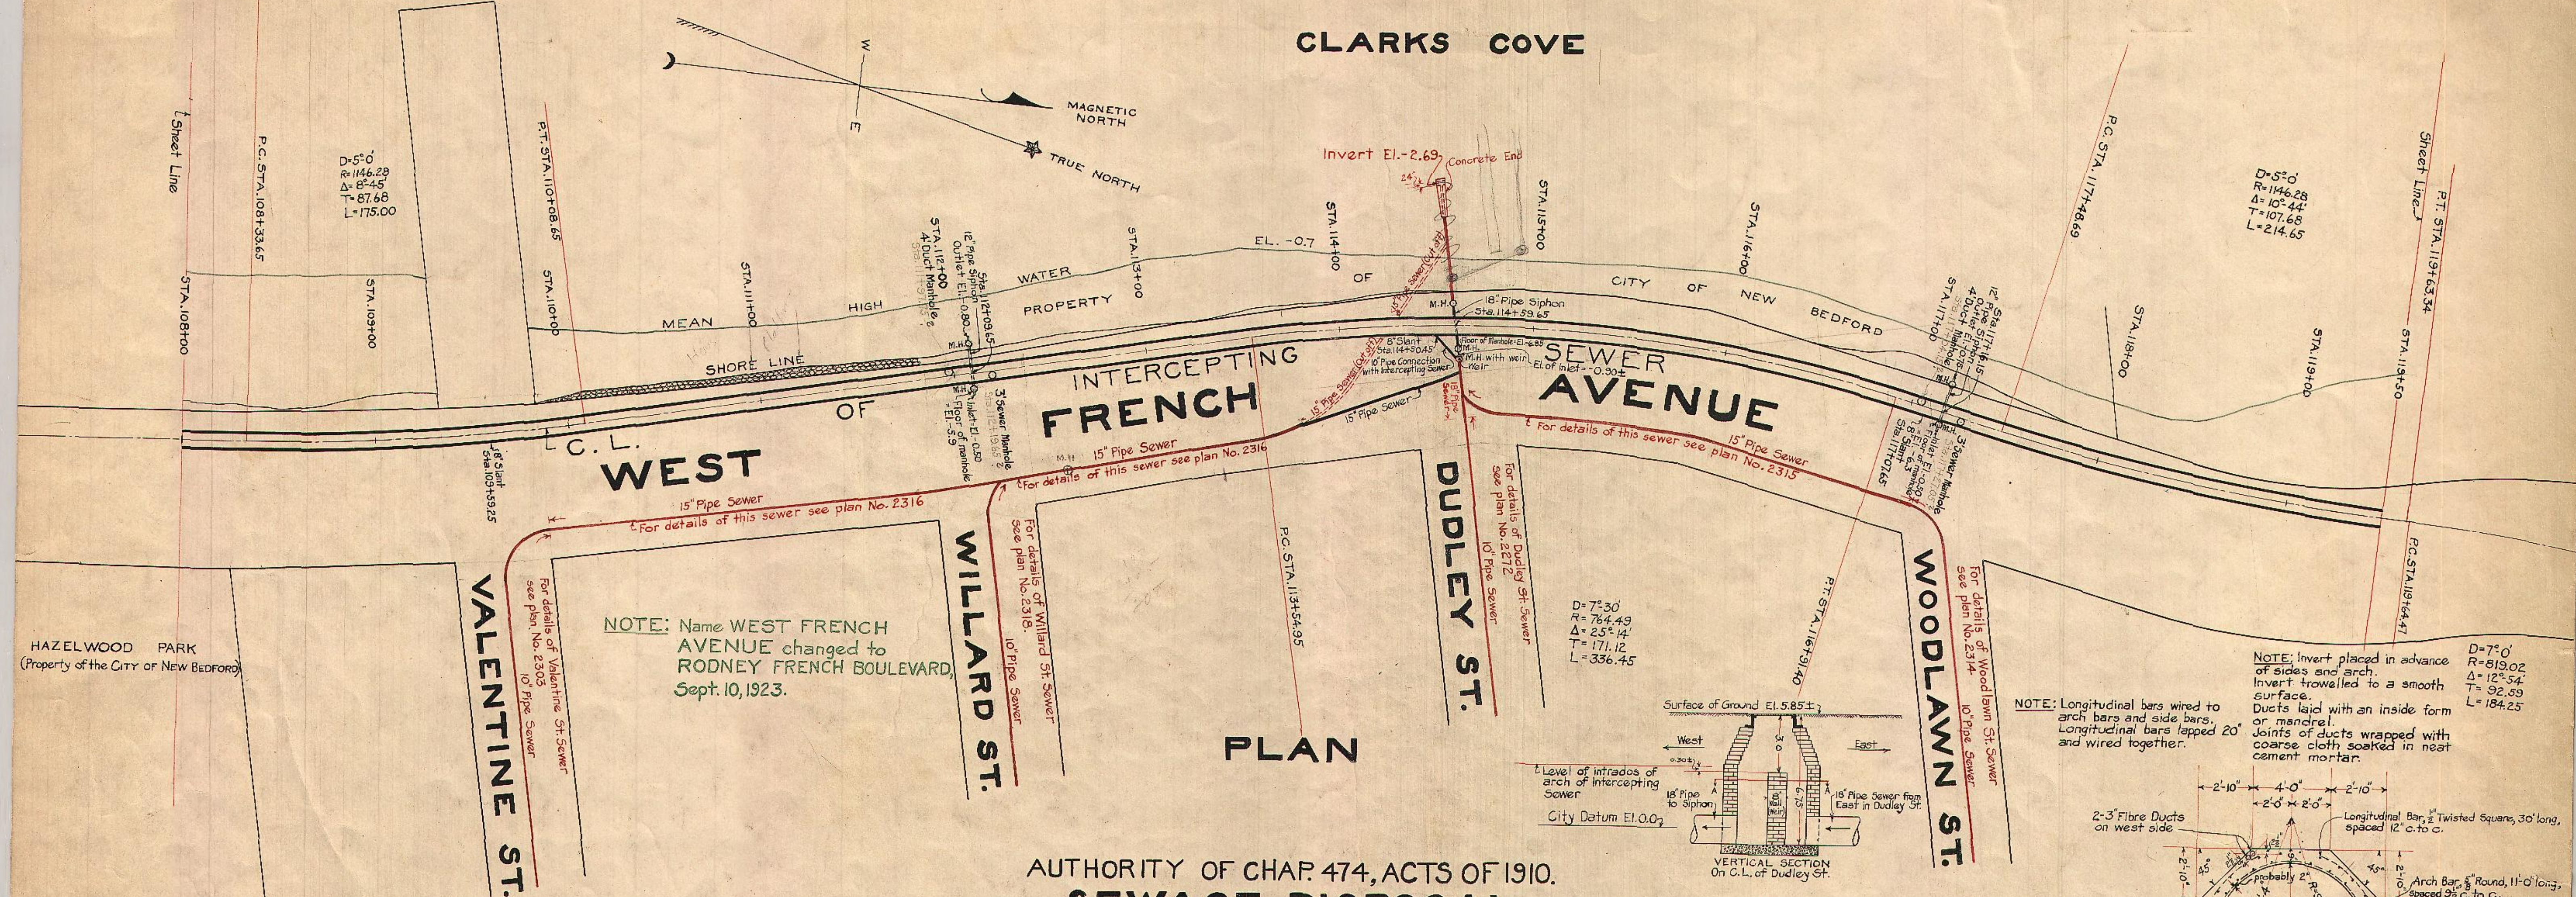

AUTHORITY OF CHAP. 474, ACTS OF 1910. SEWAGE DISPOSAL NEW BEDFORD, MASS. INTERCEPTING SEWER STA. 108+00 - STA. 119+50

SCALES: PLAN 1"=40'
PROFILE 1"=4' (Hor.) 1"=4' (Ver.)
SEPT. 1920.
SECTION 2

