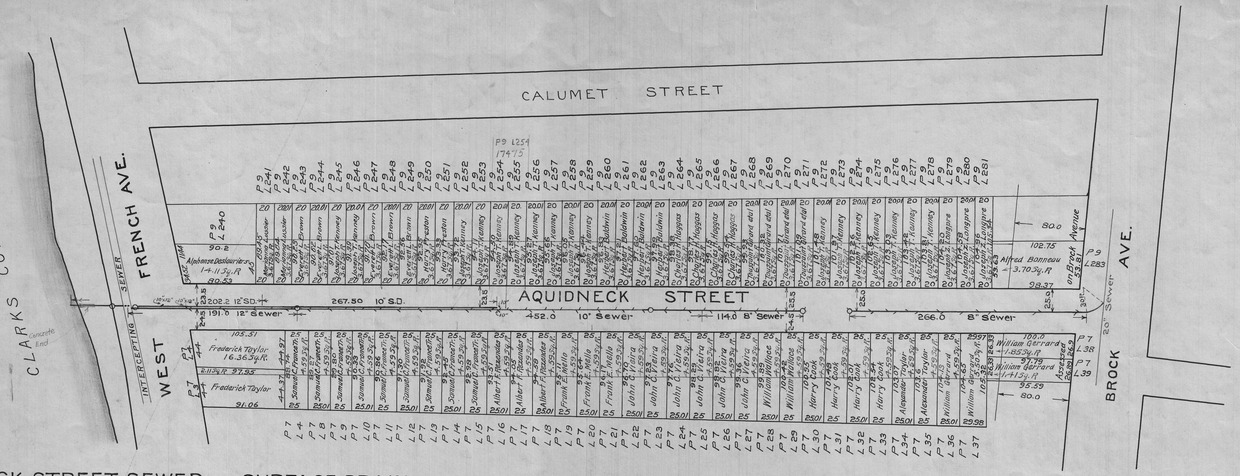

AQUIDNECK STREET SEWER AND SURFACE DRAIN

FROM BROCK AVE. TO WEST FRENCH AVE.

LENGTH

Sewer;- 191 feet of 12 inch pipe
452 feet of 10 inch pipe
402 feet of 8 inch pipe
Surface Drain; 267.8 feet of 10 inch pipe
202.2 feet of 12 inch pipe

SCALE

Horizontal;- 1 inch = 60 feet. Vertical;- 1 inch = 6 feet.

Ordered	Nov. 10, 1915
Construction Commenced	Nov. 18, 1915
Construction Completed	Dec. 24, 1915
Average Cut	9.73 % 6.20 feet
Ledge Excavated	None
Cost	$ 2488.65
Amount Assessed	$ 1712.00

Foreman; Jos. Frazier & Wm. Smith

Field Book 409 p. 24, 25, 33.
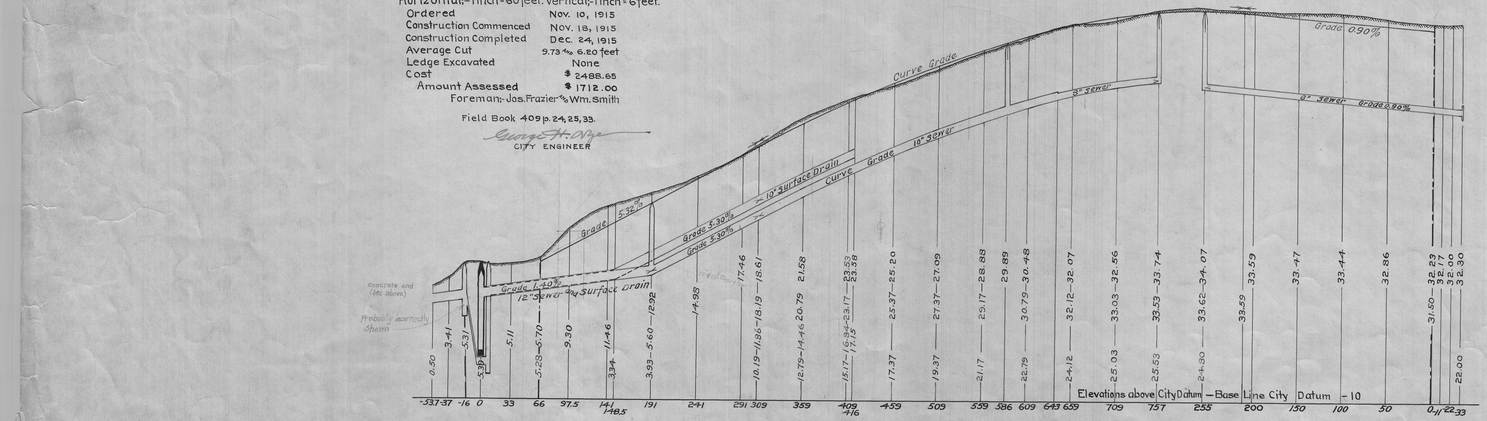
CITY ENGINEER