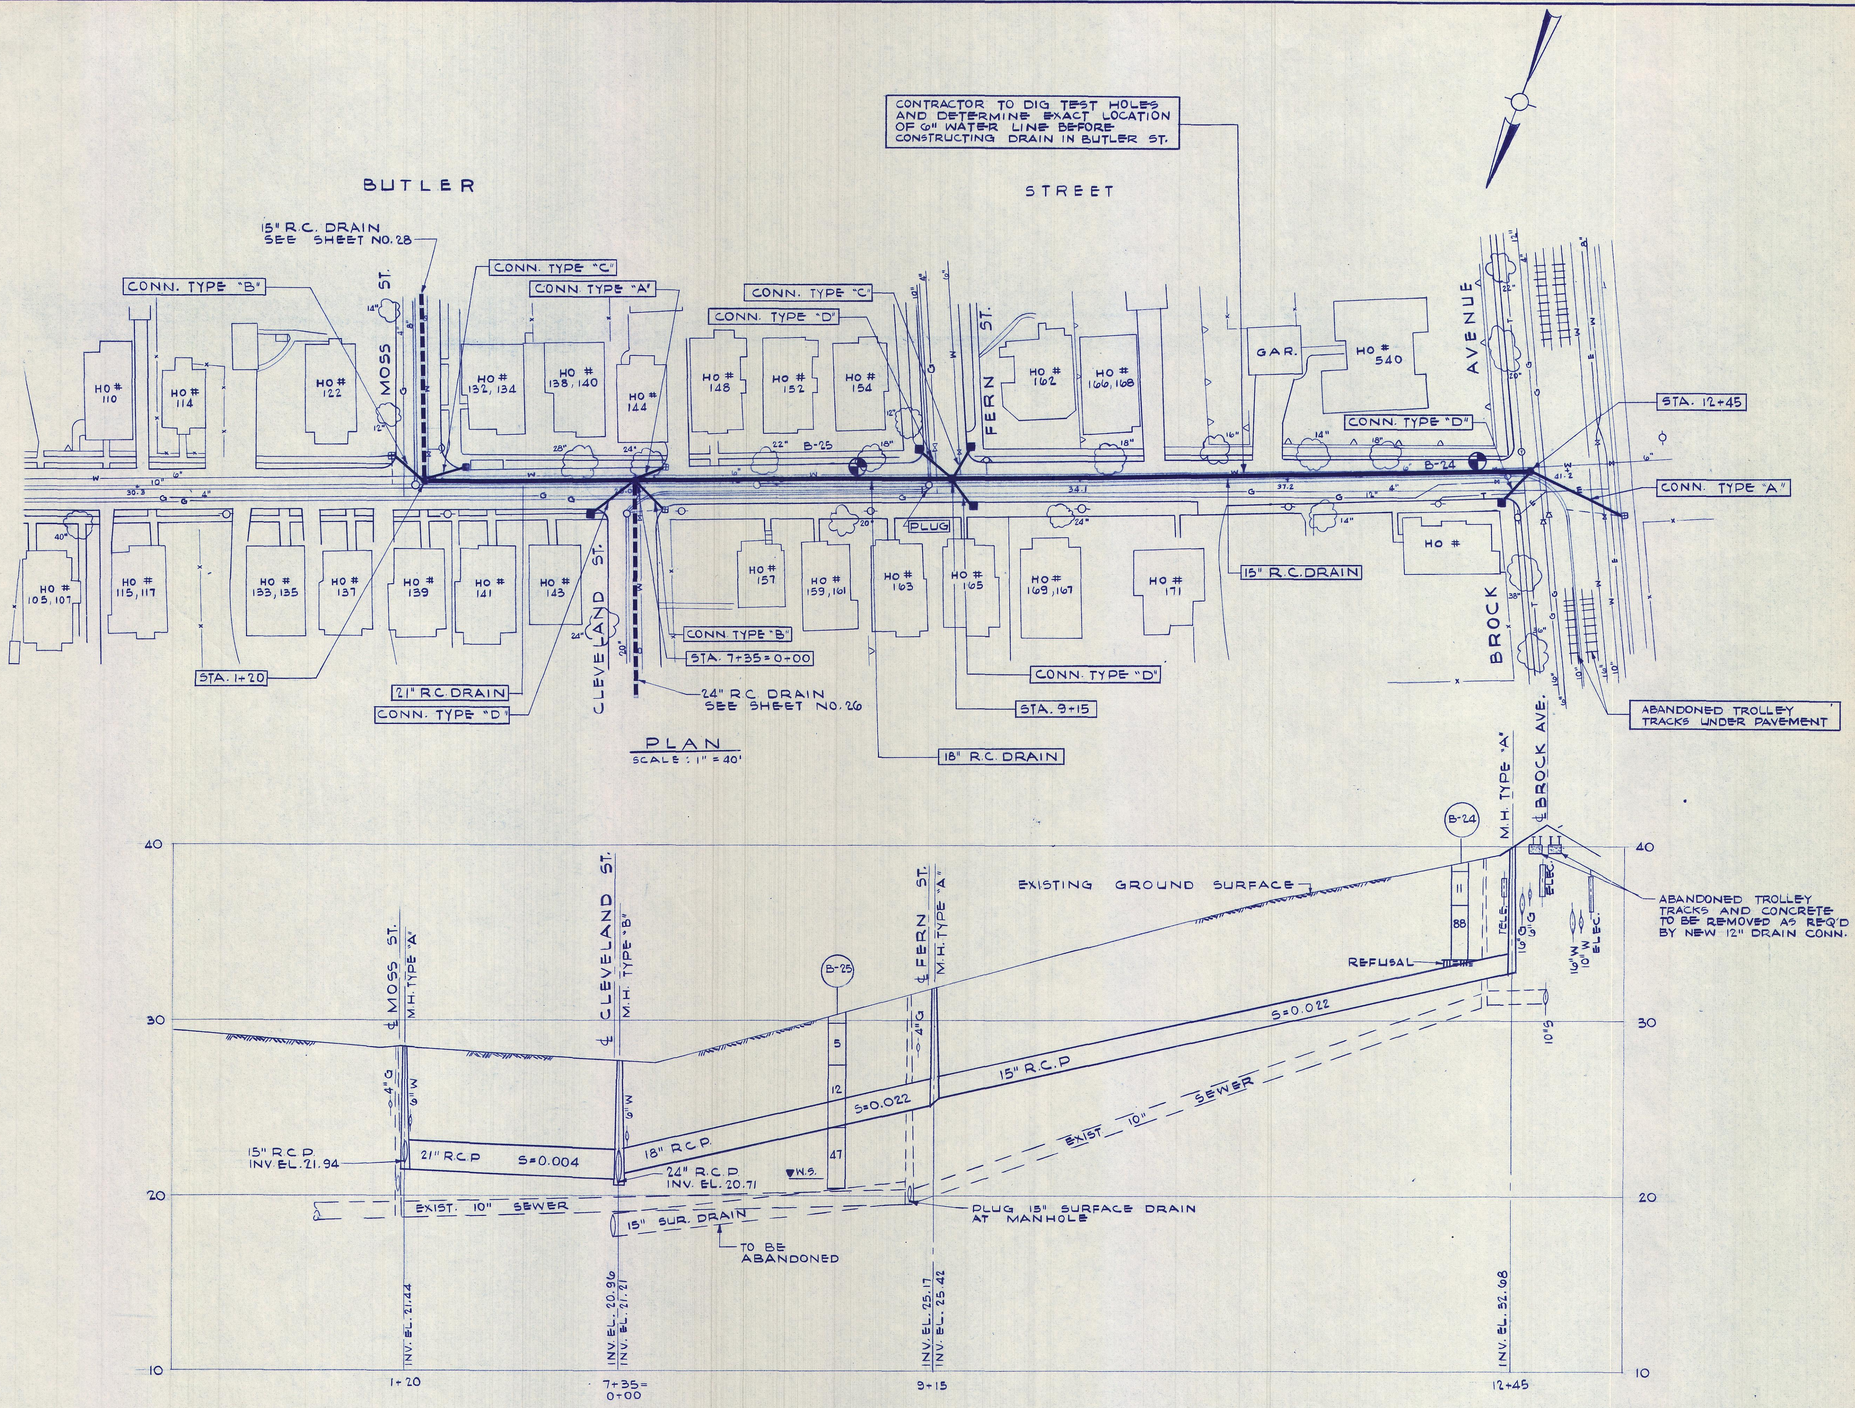

PLAN
SCALE: 1" = 40'

PROFILE
SCALE: HOR. 1" = 40'
VERT. 1" = 4'

Approved by:	Date	Name
Structural		
Electrical		
HVAC		
Project Engineer	1/4/79	J.P.S.
Project Manager	1/4/79	W. Rogers

ANDREW T. JOHNSON CO., INC. 2974

Date	Ch'k'd.	Revision

Designed by: W.T.C
Drawn by: B.G.
Checked by: W.H.R.
Approved by: W.H.F.
Date: SEPTEMBER 1977
Scale: AS NOTED

COMMONWEALTH OF MASSACHUSETTS ROBERT G. MARINI No. 8066 REGISTERED PROFESSIONAL ENGINEER

CITY OF NEW BEDFORD, MASSACHUSETTS
DEPARTMENT OF PUBLIC WORKS
DRAINAGE WORKS IMPROVEMENTS
CLARKS POINT SEPARATION – EAST SIDE

BUTLER ST.

CAMP DRESSER & McKEE Inc.
Consulting Engineers
Boston, Mass.

SHEET NO. 27
309-28371