

SHEET 1
BUTLER STREET RELIEF SEWER
SURFACE DRAIN IN
FREDERICK, CLEVELAND AND BUTLER STREET


LENGTH

658 feet of glazed pipe	33 inches in diameter
520 feet of glazed pipe	30 inches in diameter
350 feet of glazed pipe	27 inches in diameter
221 feet of glazed pipe	24 inches in diameter
261 feet of glazed pipe	20 inches in diameter
173 feet of glazed pipe	15 inches in diameter
122 feet of glazed pipe	10 inches in diameter

SCALE
Horizontal; 1 inch = 60 feet. Vertical; 1 inch = 6 feet.

Ordered	April 22, 1915
Construction Commenced	May 6, 1915
Construction Completed	July 17, 1915
Average Cut	7.03 feet
Ledge Excavated	None
Cost	
Amount Assessed	None
Foreman	John Daley
Field Book	409 p. 2.

CITY ENGINEER

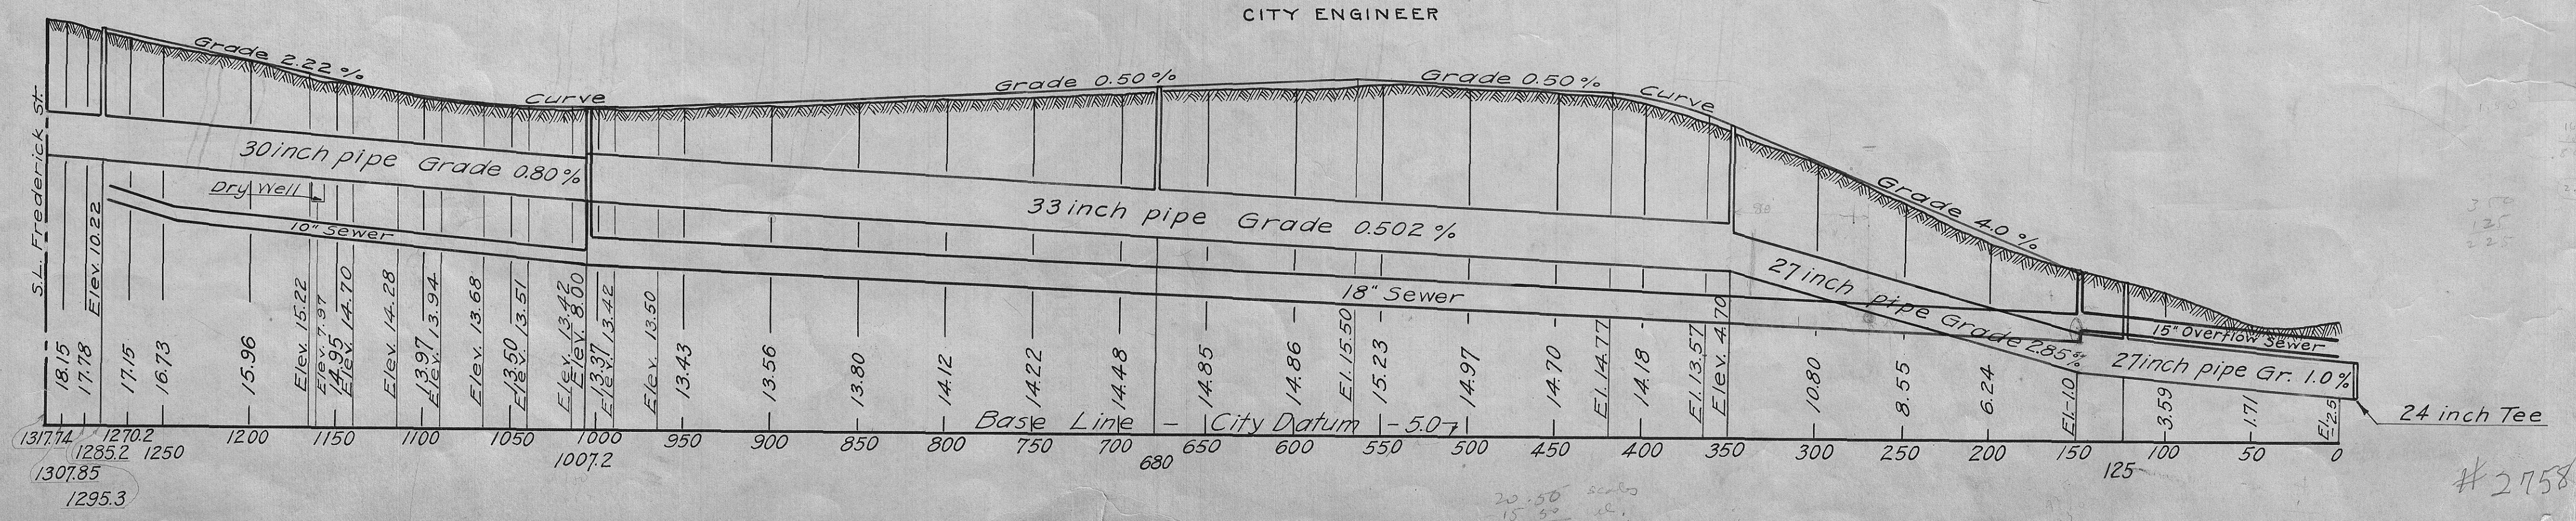

#2758