
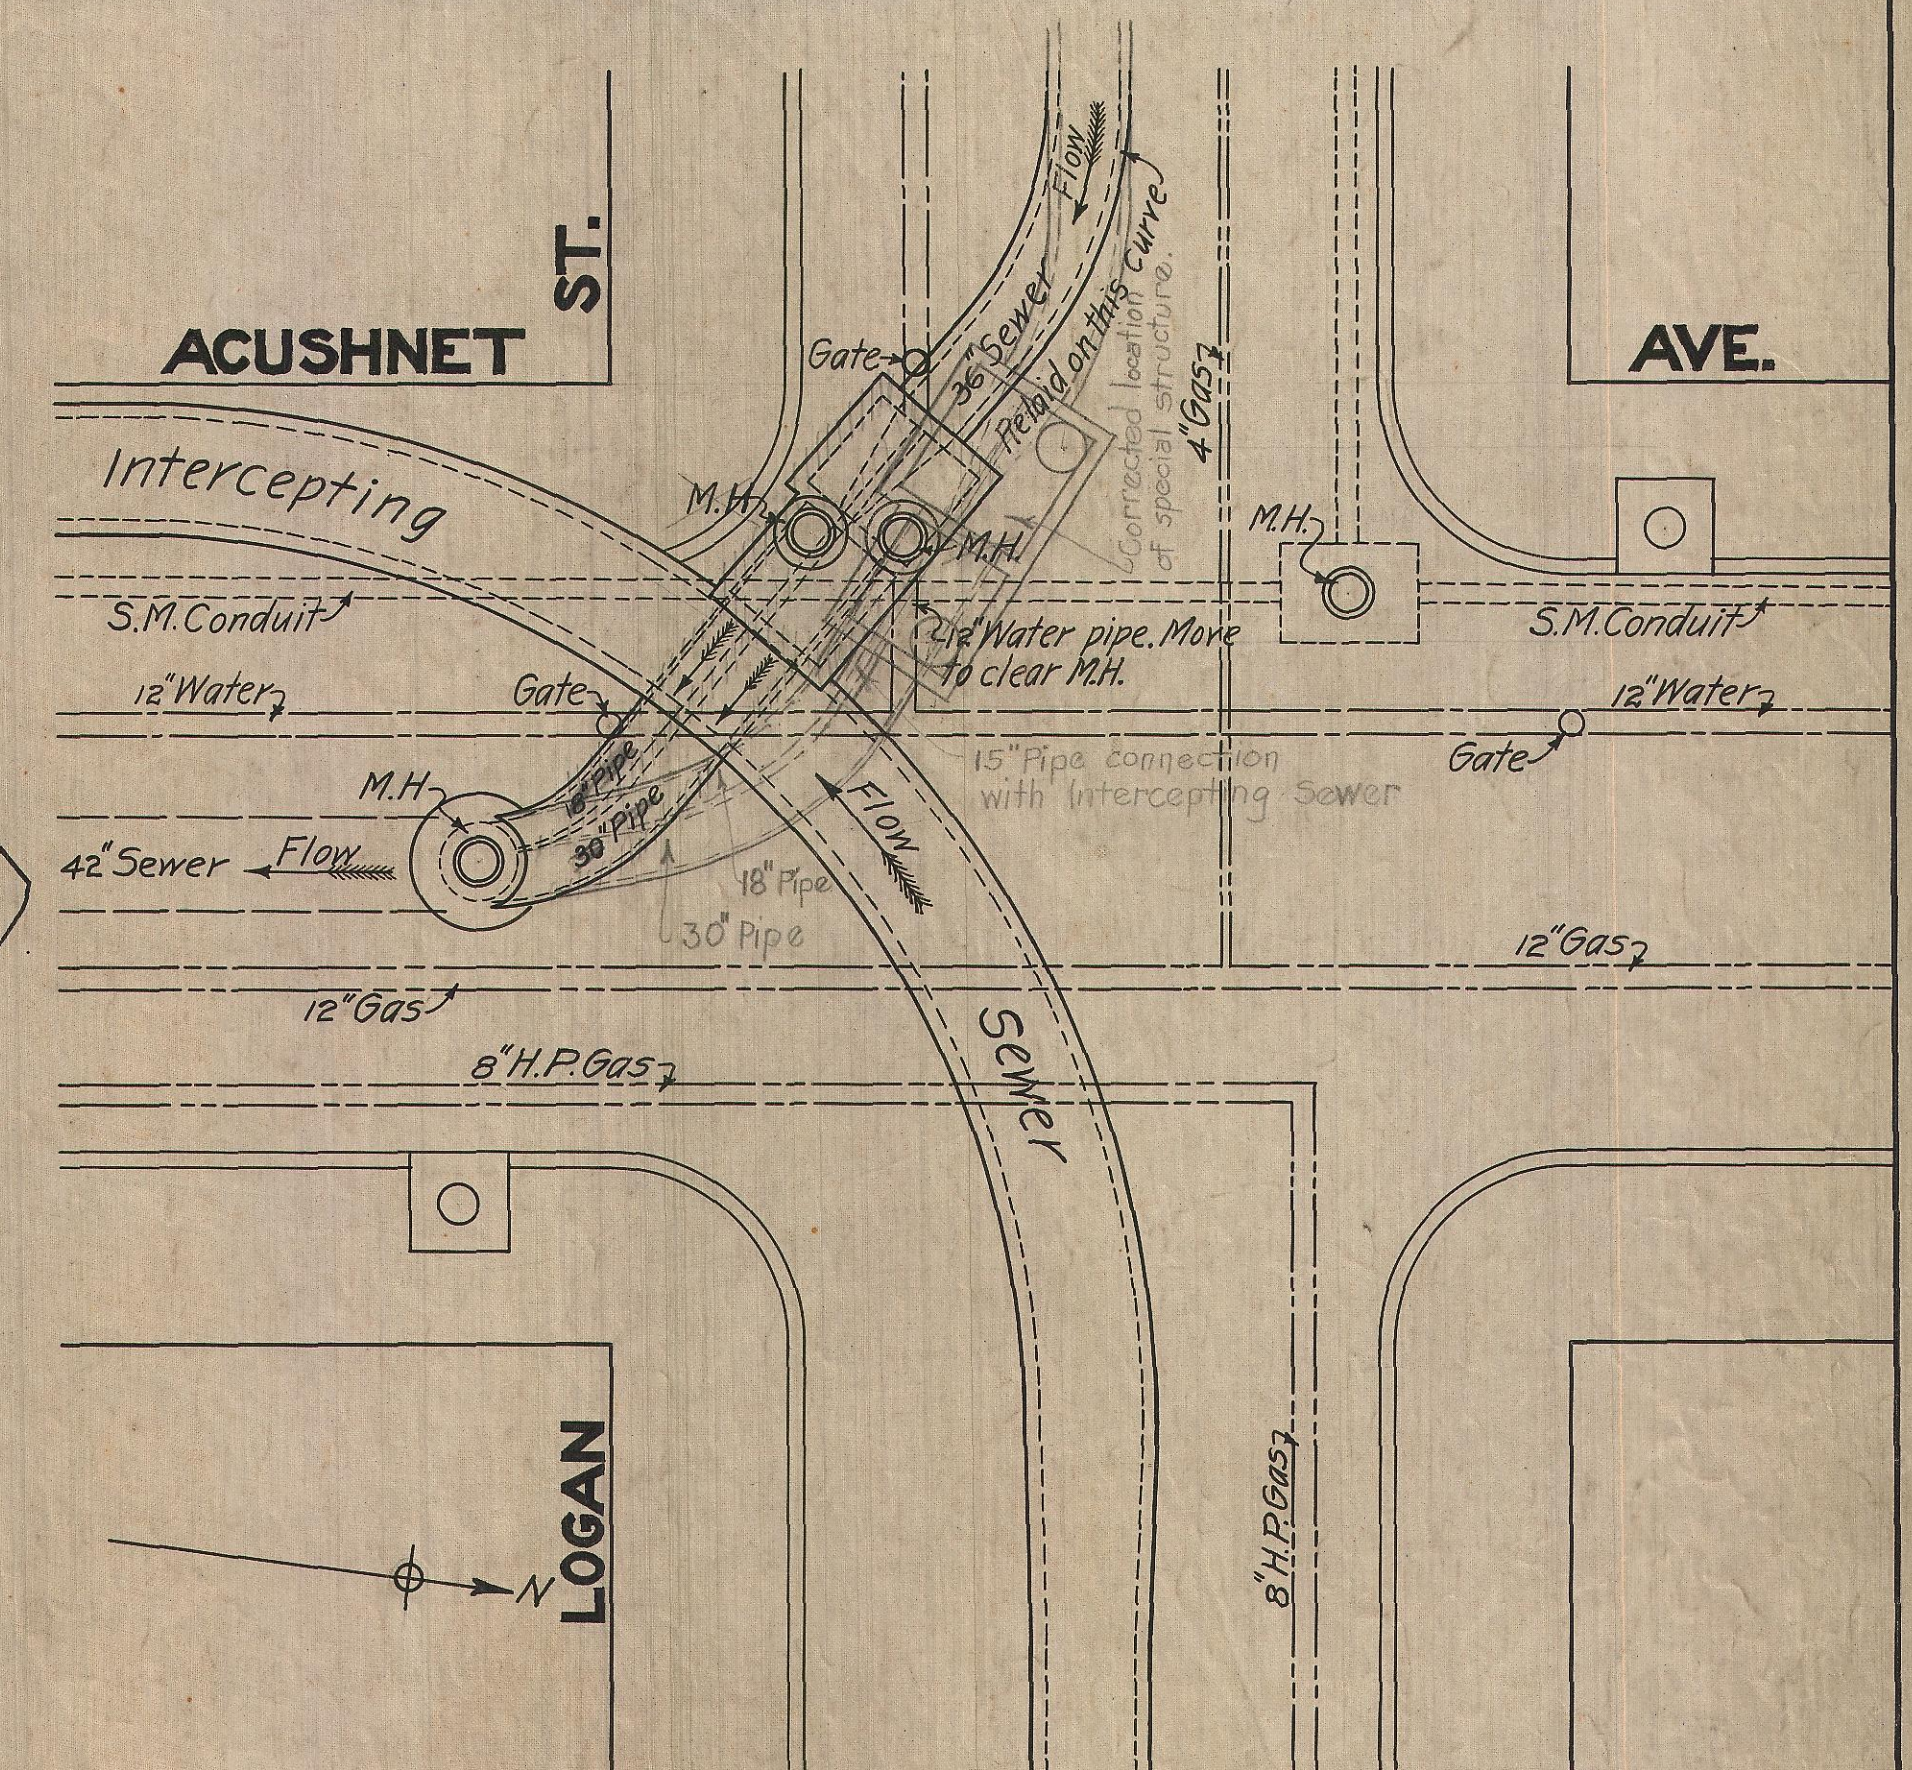
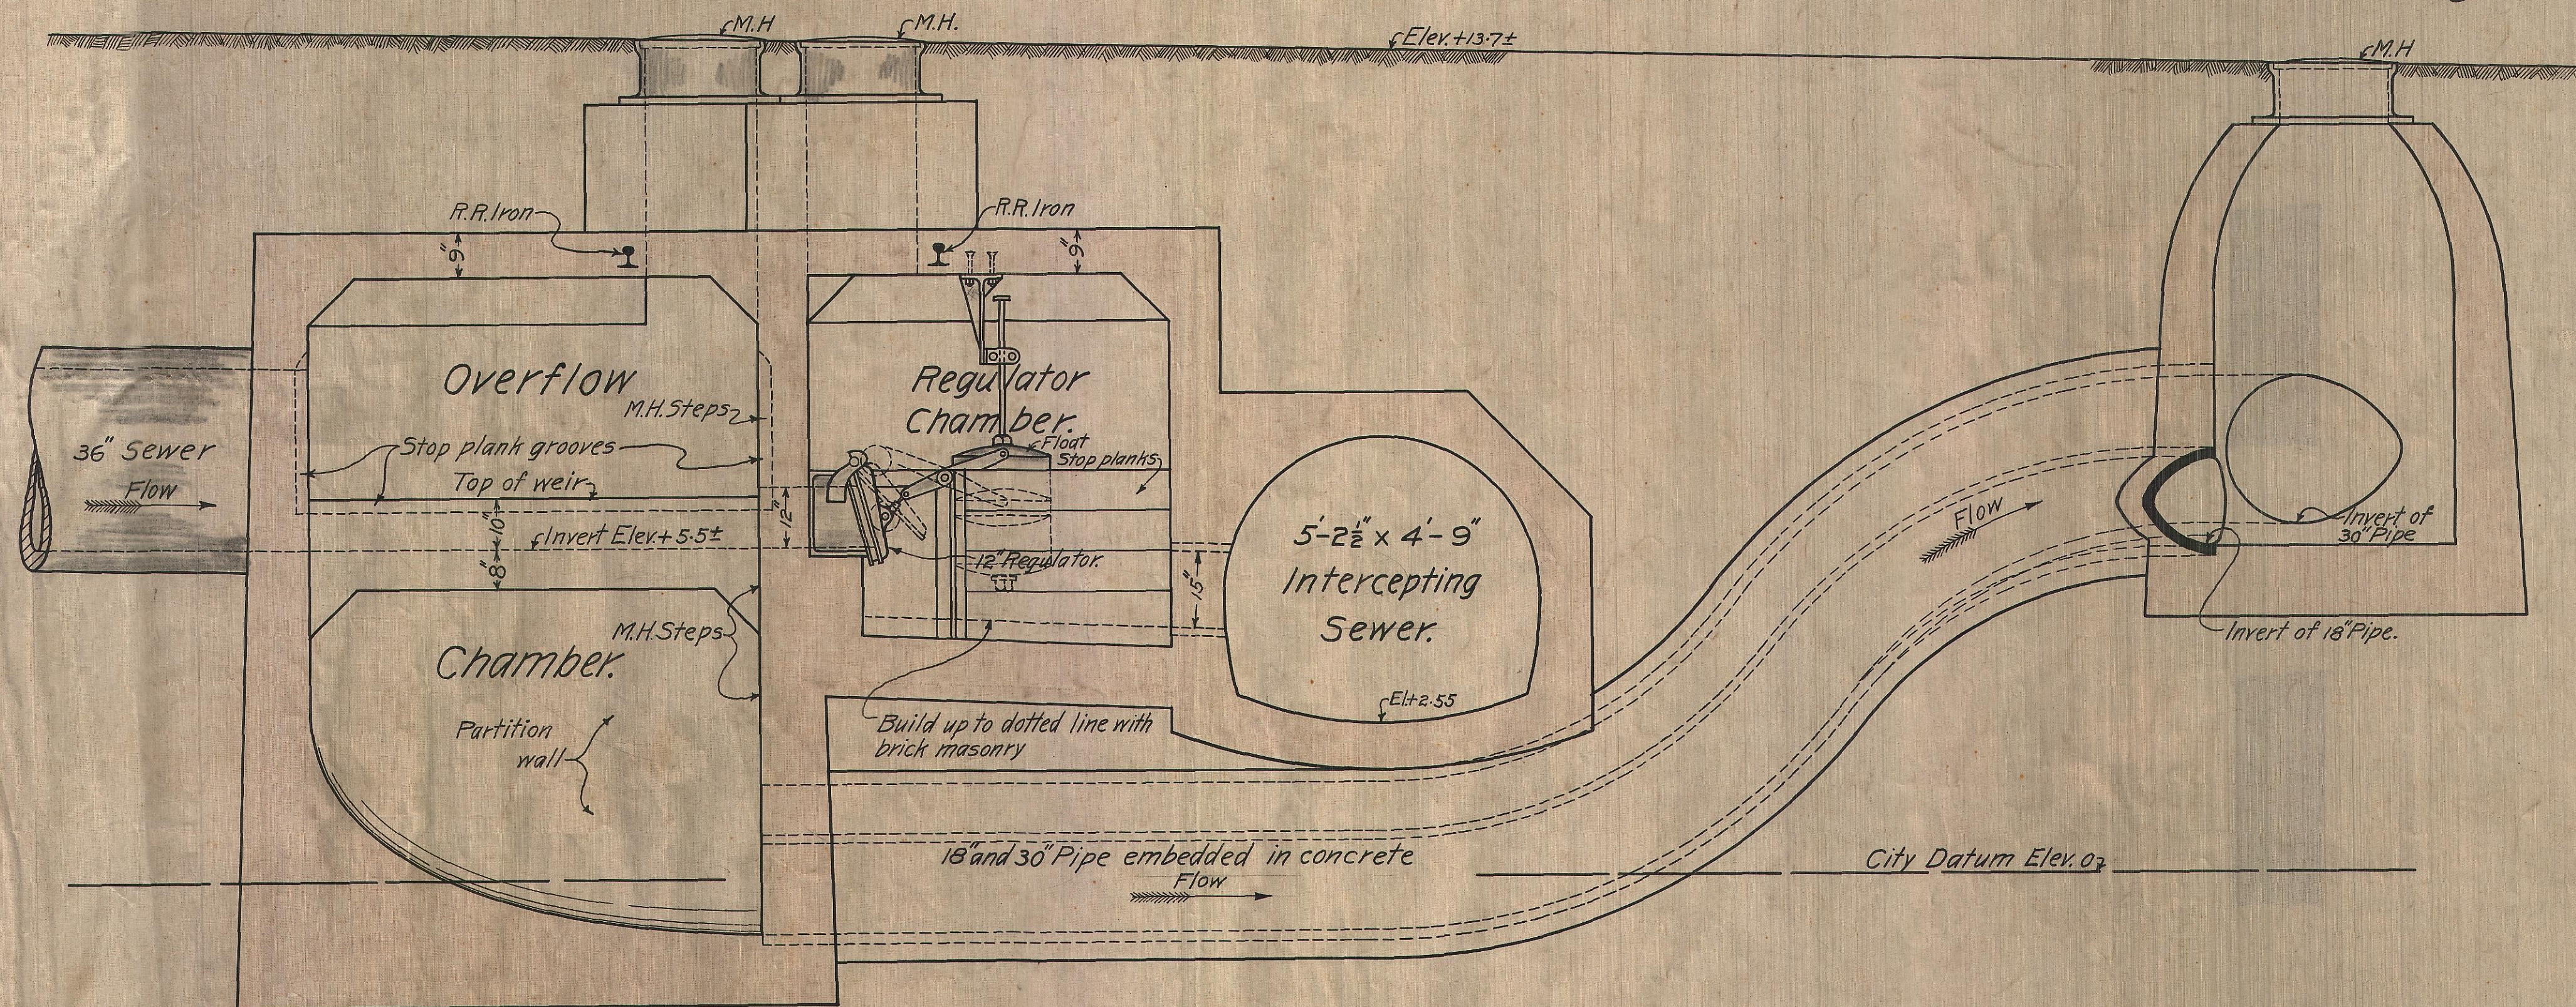


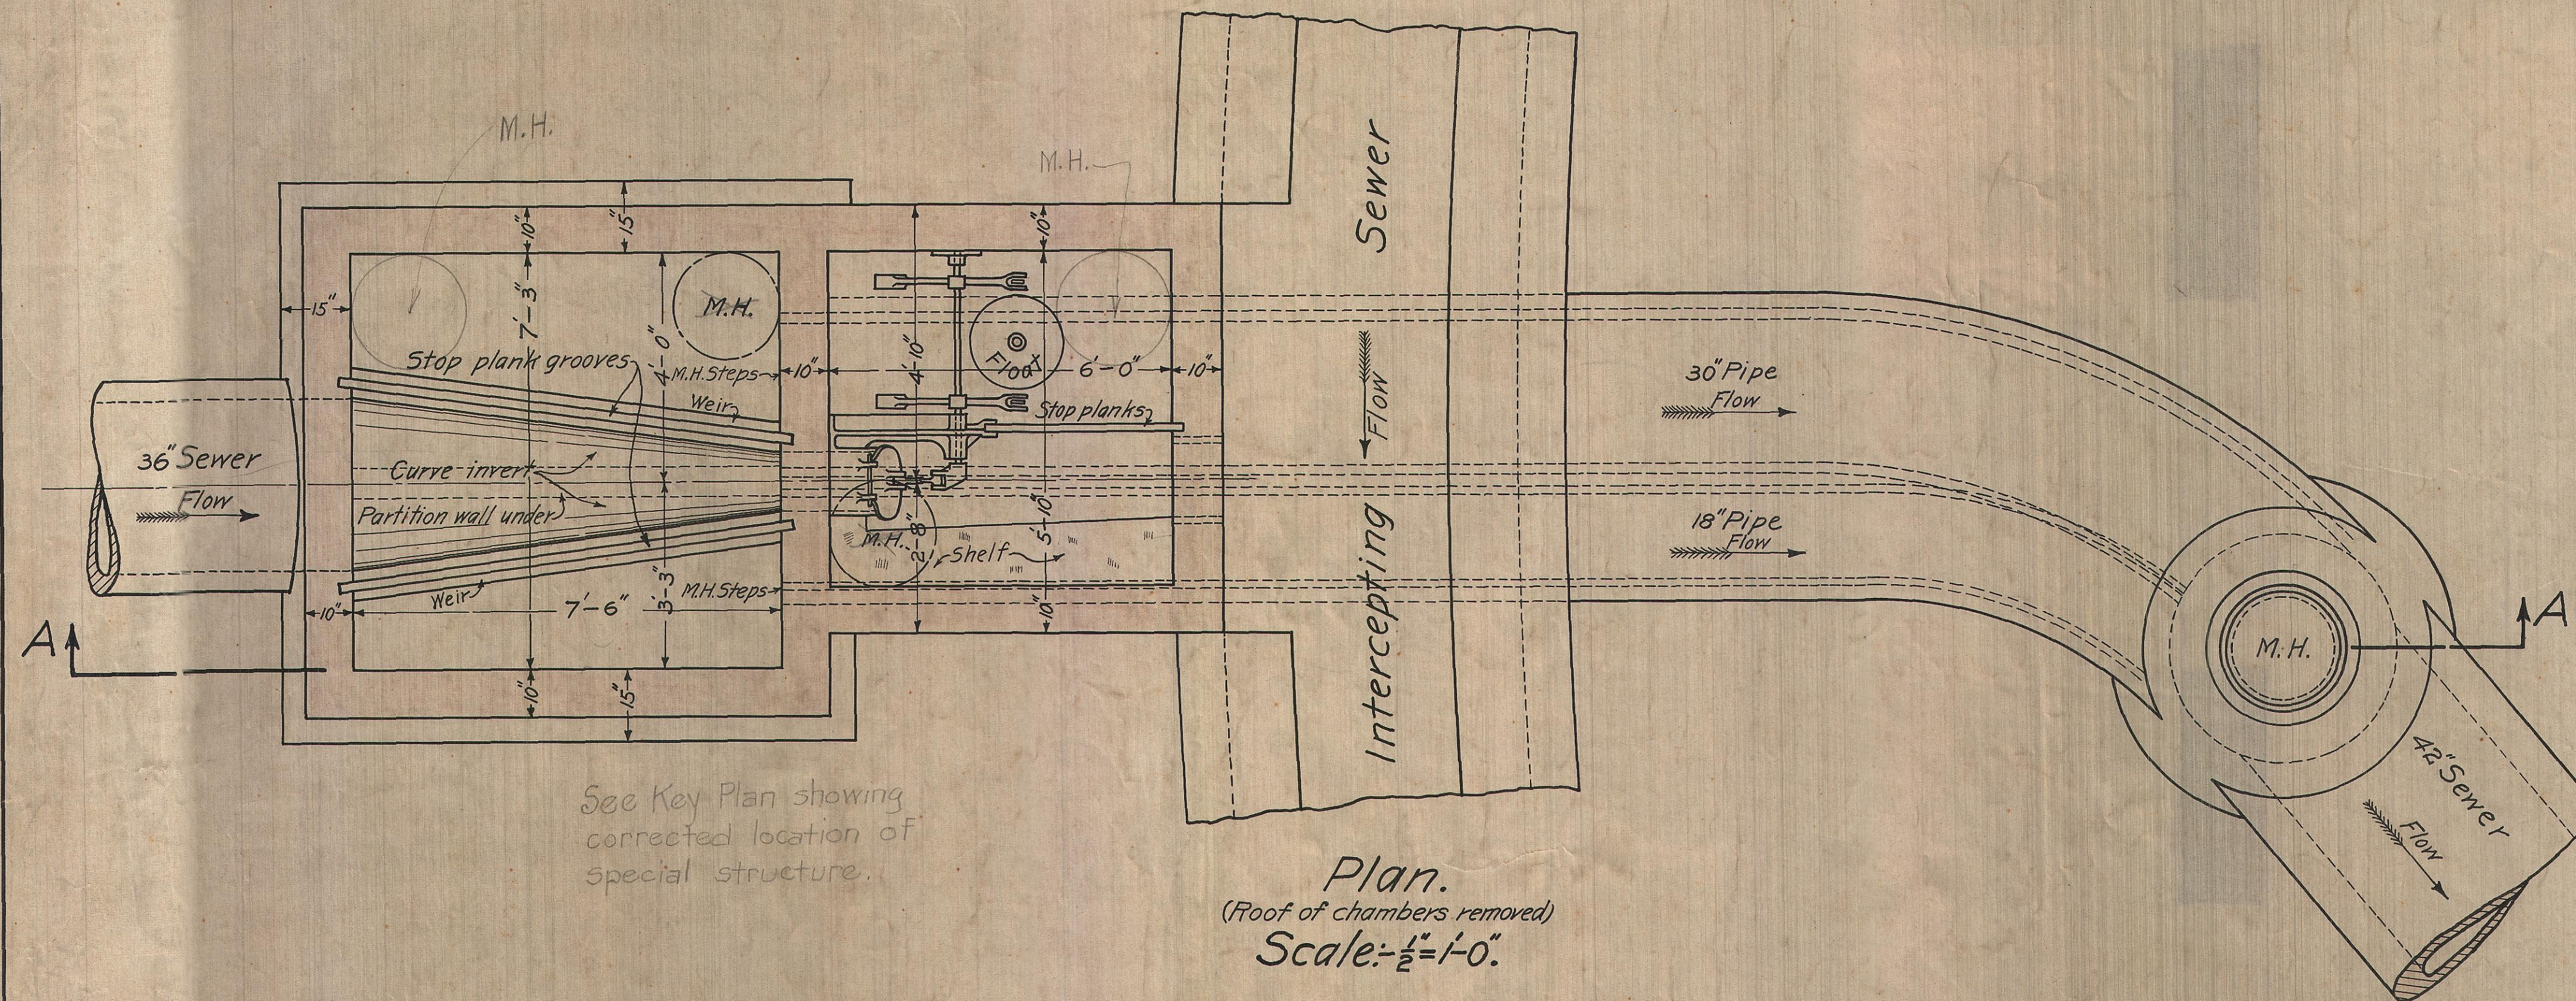

City of New Bedford
Intercepting Sewer System
12-IN REGULATOR CONNECTION
at Logan St. and Acushnet Ave.

Scales as noted. July, 1915.
William F. Williams
Consulting Engineer.