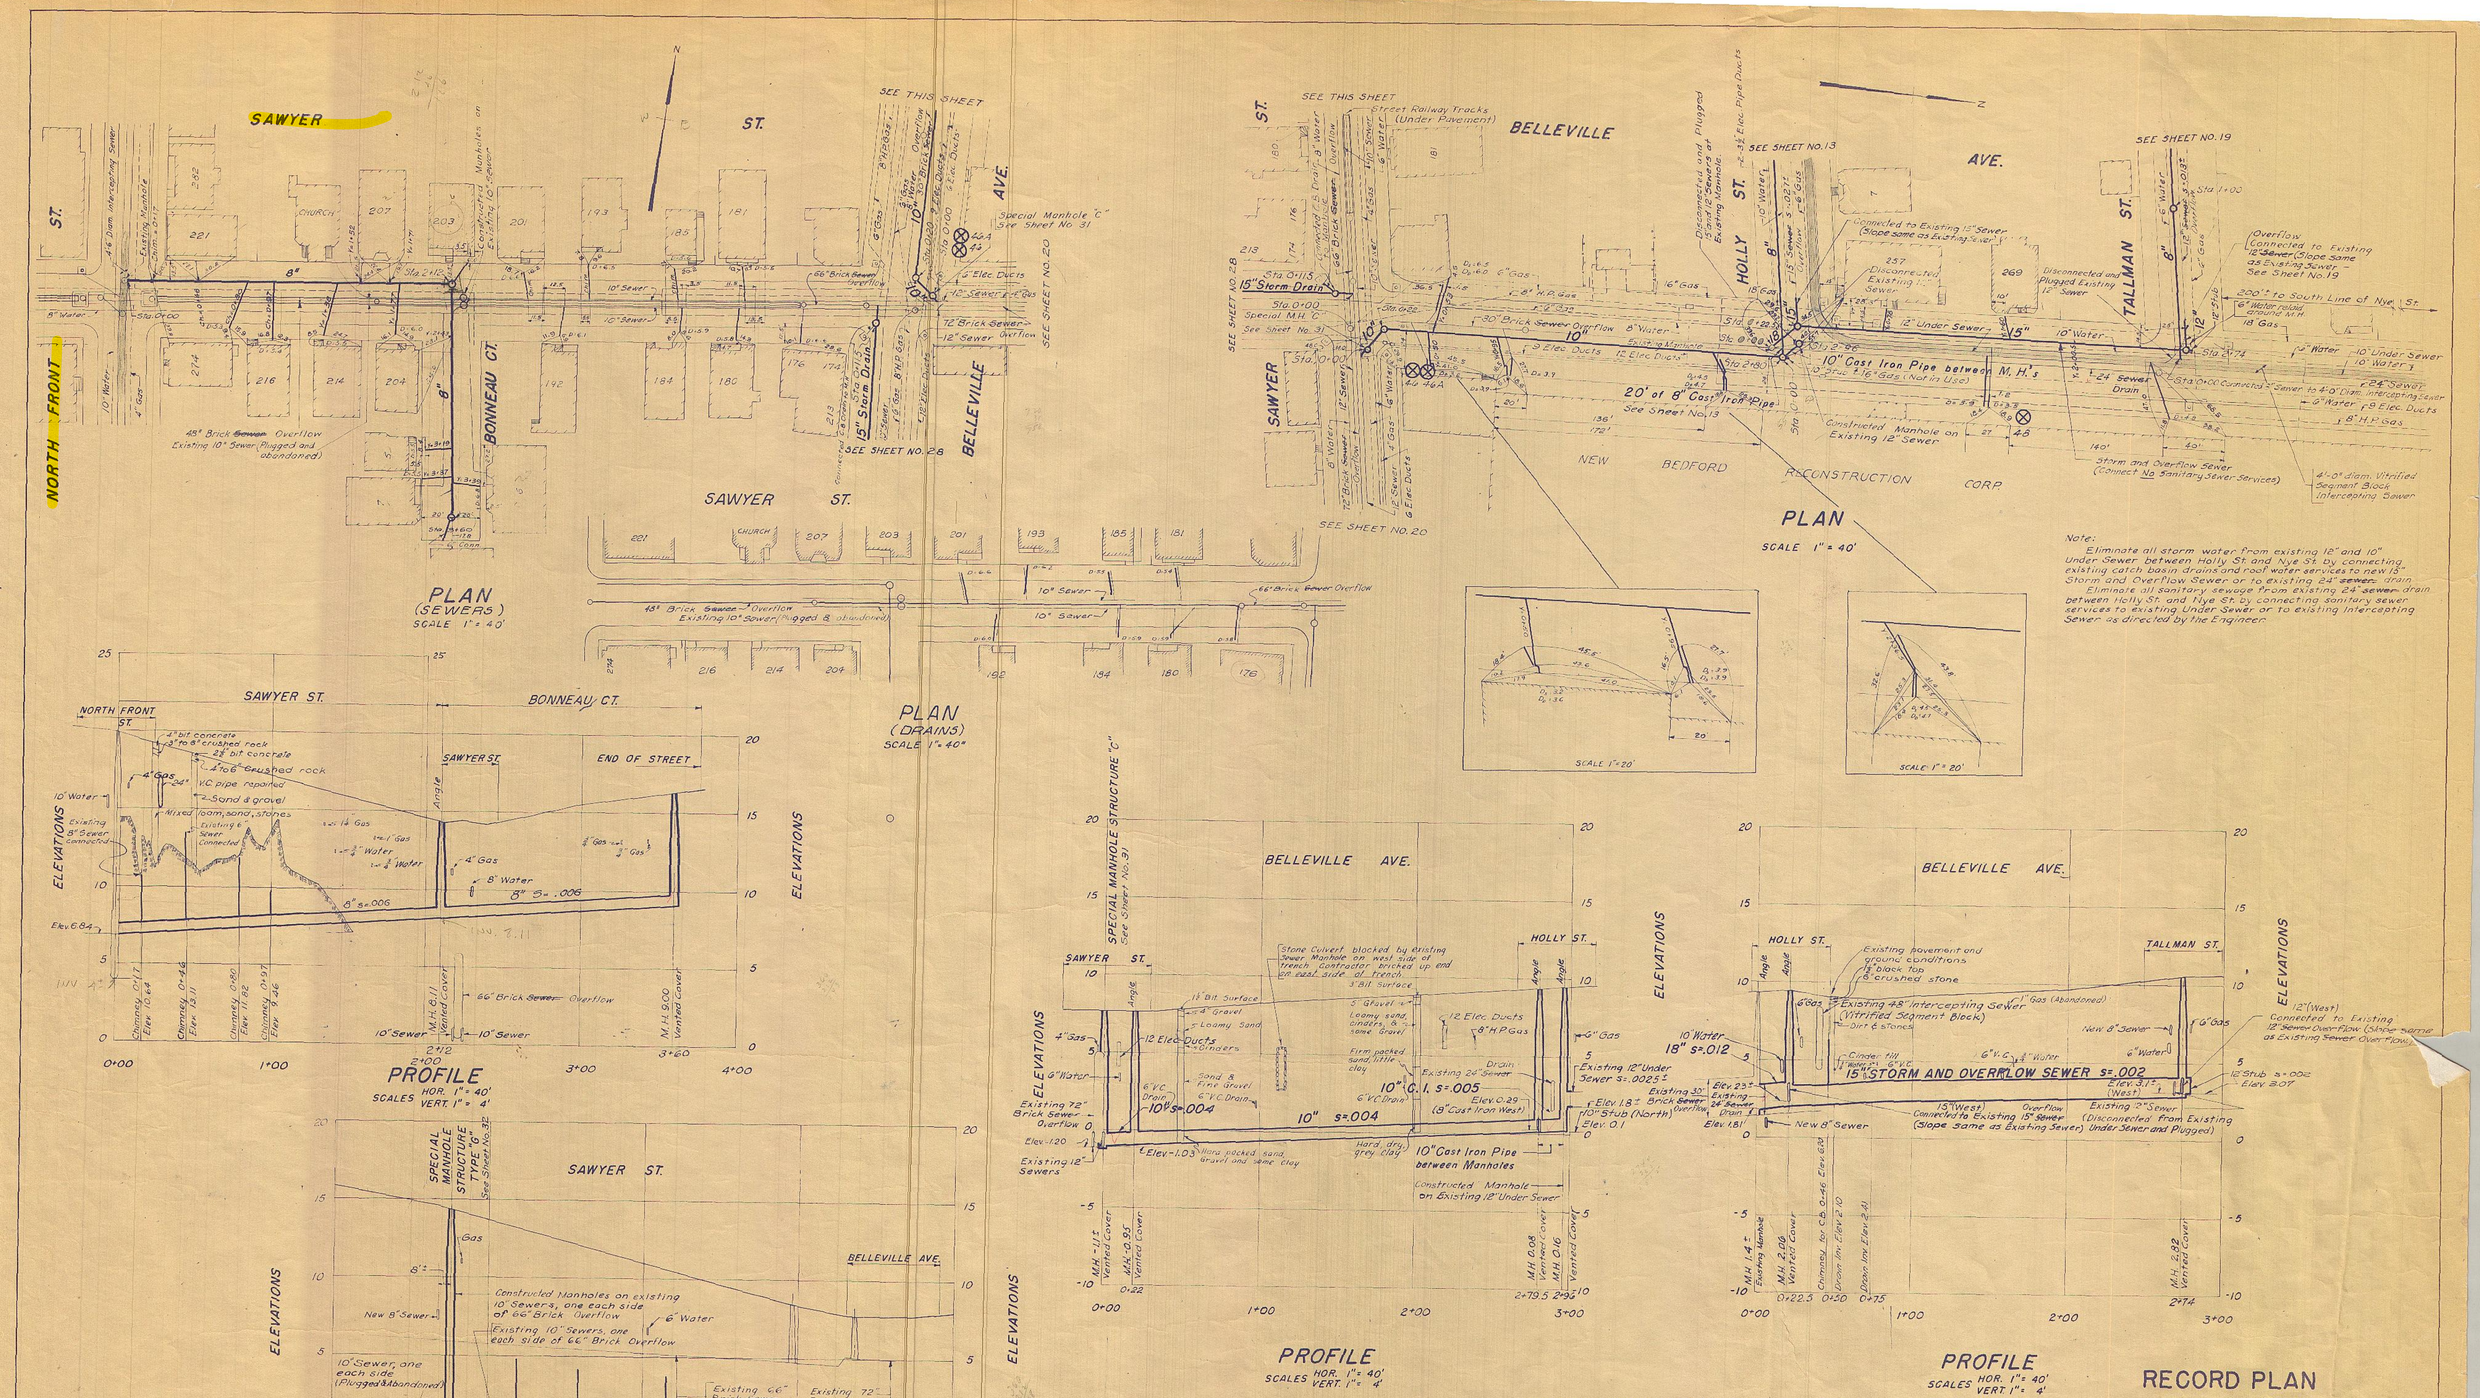
SAWYER ST.
NORTH FRONT ST.
BONNEAU CT.
BELLEVILLE AVE.
HOLLY ST.
TALLMAN ST.
NEW BEDFORD RECONSTRUCTION CORP.
PLAN (SEWERS) SCALE 1" = 40'
PLAN (DRAINS) SCALE 1" = 40'
PLAN SCALE 1" = 40'
PROFILE HOR. 1" = 40' VERT. 1" = 4'
PROFILE SCALES HOR. 1" = 40' VERT. 1" = 4'
RECORD PLAN
FOR DETAILS, GENERAL NOTES AND LEGEND SEE SHEET NO. 29 AND SHEET NO. 33
NEW BEDFORD, MASSACHUSETTS
DEPARTMENT OF PUBLIC WORKS
ADDITIONS TO INTERCEPTING SEWER SYSTEM
SEWERS
SAWYER ST. (NORTH FRONT ST. to BONNEAU CT.)
BONNEAU CT. (South of SAWYER ST.)
BELLEVILLE AVE. (HOLLY ST. to TALLMAN ST.)
BELLEVILLE AVE. (SAWYER ST. to HOLLY ST.)
SCALE AS NOTED
OCT 1948
FAY, SPOFFORD & THORNDIKE, ENGINEERS, BOSTON, MASS.
Jn-1
28
CONTRACT DRAWING
SHEET NO. 21 OF 33