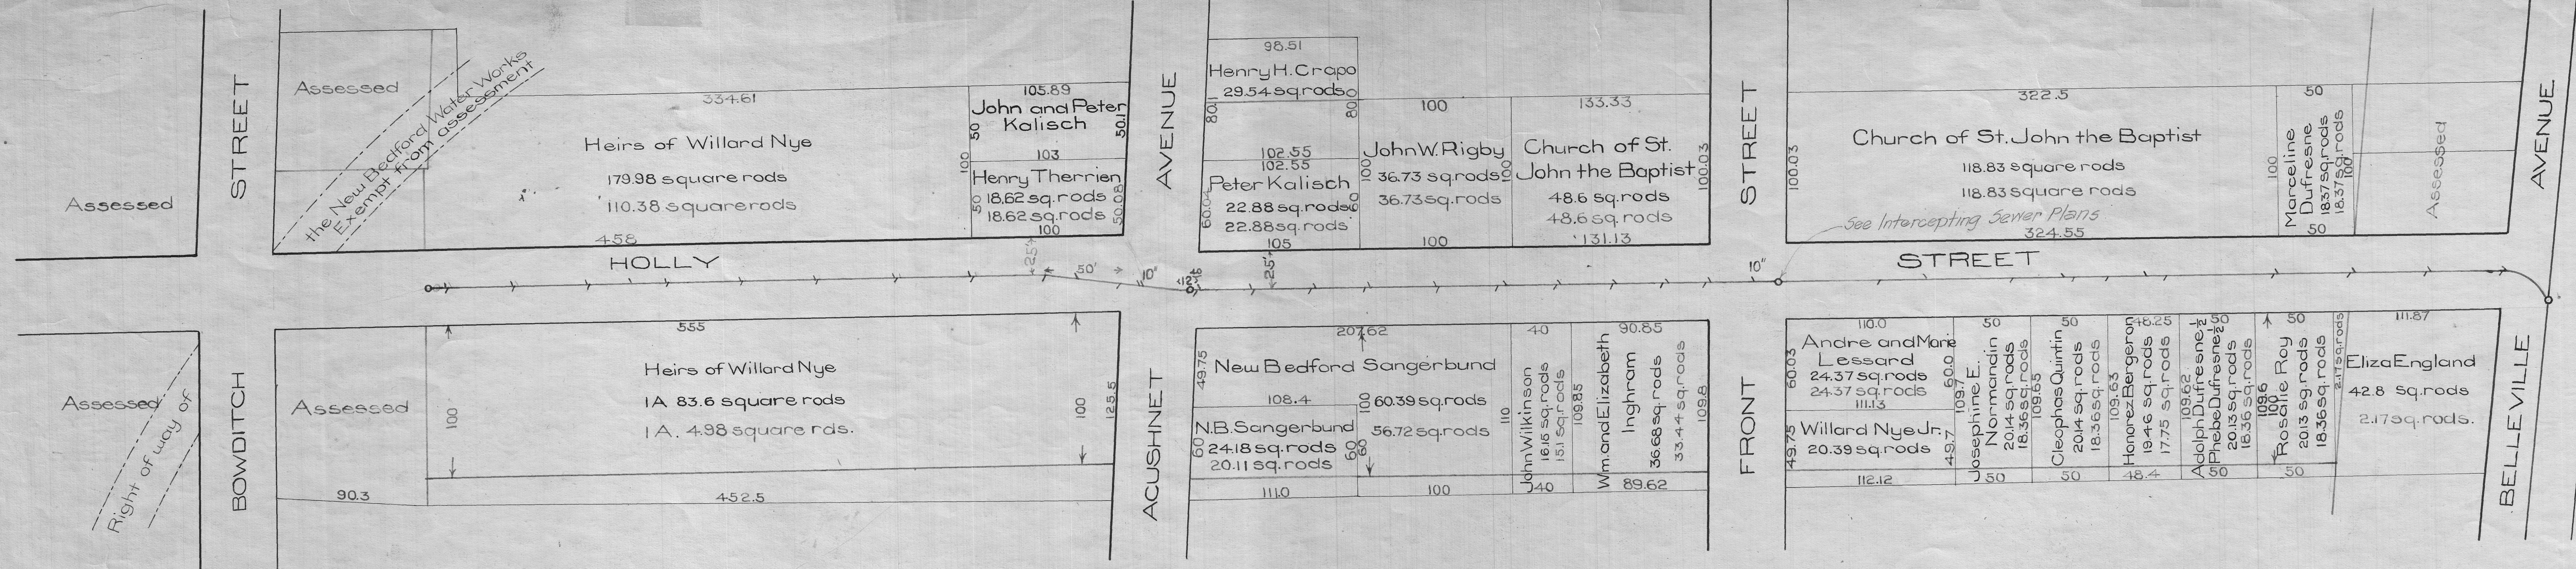

HOLLY STREET SEWER
FROM BELLEVILLE AVE. TO BOWDITCH ST.

LENGTH

234.0	feet of glazed pipe 15 inches in diameter
277.8	" " " " 12 " " "
884.0	" " " " 10 " " "
1395.8	

SCALE

Horizontal, 1 inch = 60 feet Vertical, 1 inch = 6 feet

BENCH MARK

Stone-bound on N.W. cor. Acushnet Ave. & Sawyer St. 29^{44}

Ordered	
Construction Commenced	May 16, 1899
Average Depth	7.28 feet
Ledge Excavated	2 cu. yds.
Cost	$1260.70
Amount Assessed	$630.35
Foreman	Alexander Cook

Field book 107 page 32

William F. Williams
CITY ENGINEER.