


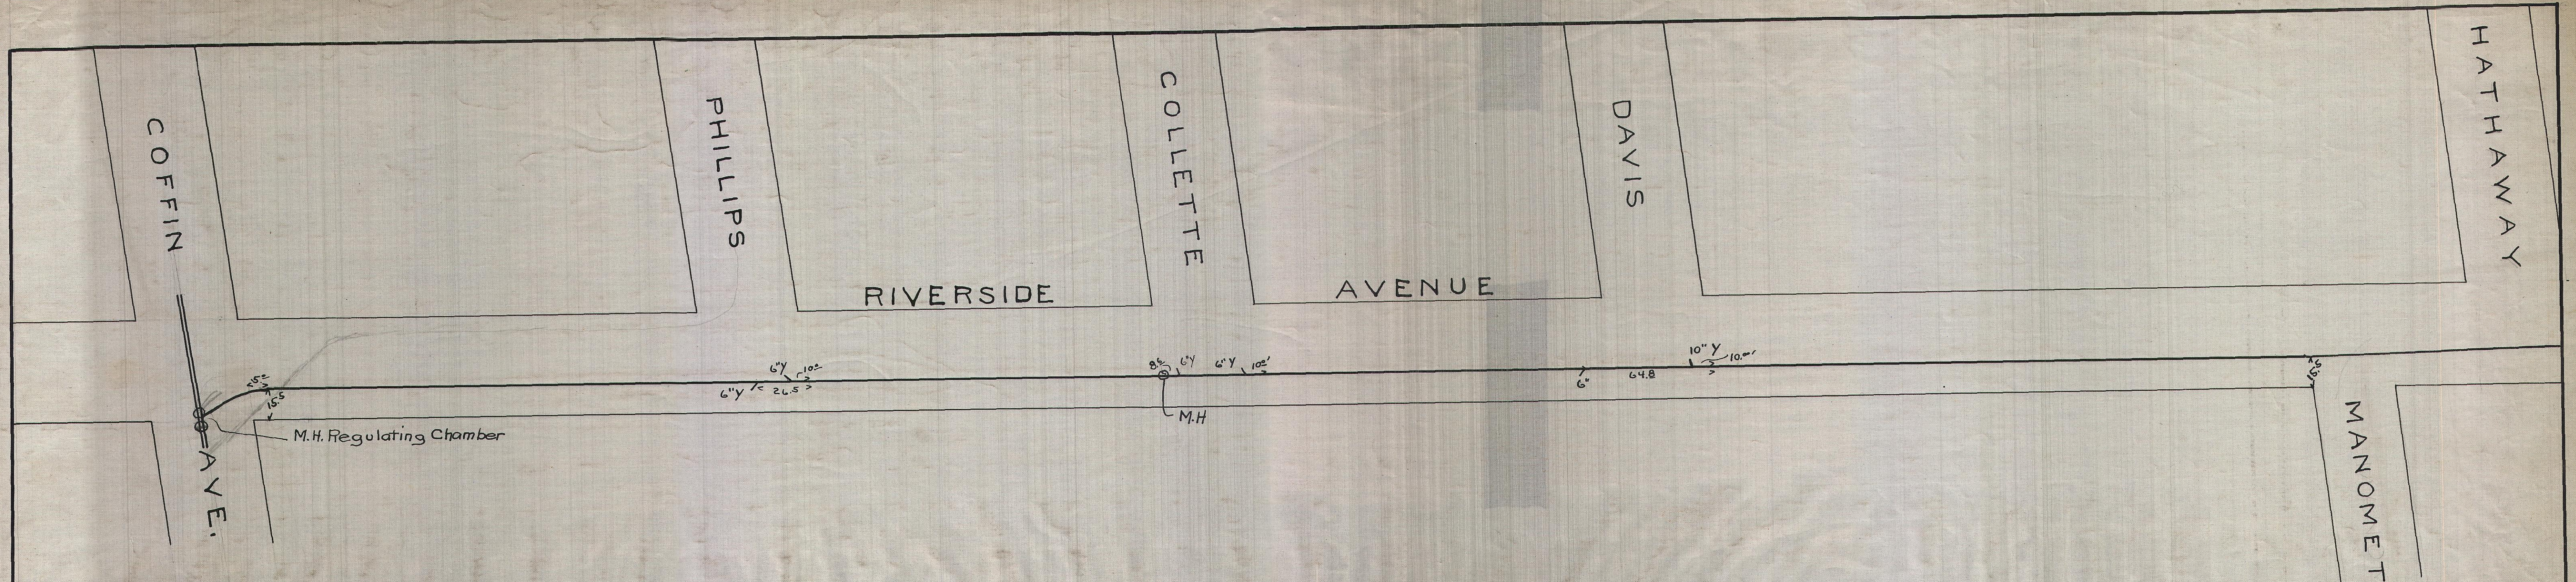

Note: See revised general (white paper) drawings of Intercepting Sewer showing sewer in Riverside Ave. as constructed.

**CITY OF NEW BEDFORD
INTERCEPTING SEWER SYSTEM
RIVERSIDE AVE. SEWER
MAY 1917**

CONSULTING ENGINEER

SCALES { HORZ. 1"=40'-0"
VERT. 1"= 4'-0"

