2361

HATHAWAY STREET SEWER

FROM 19.75 FT. W. OF RIVERSIDE AVENUE TO HOPE ST.

LENGTH

520.45 ft. of glazed pipe 36 inches in diam.

Horizontal scale, 1 inch = 20 ft. Vertical, 1 in = 4 ft.

Ordered June 22, 1905


Construction Commenced Aug. 12, 1905

Cost - See Manomet St. and Riverside Ave. sewer

Foreman Martin Ryan


Field-book 211 pages 18, 19, and 26

William F. Williams
CITY ENGINEER

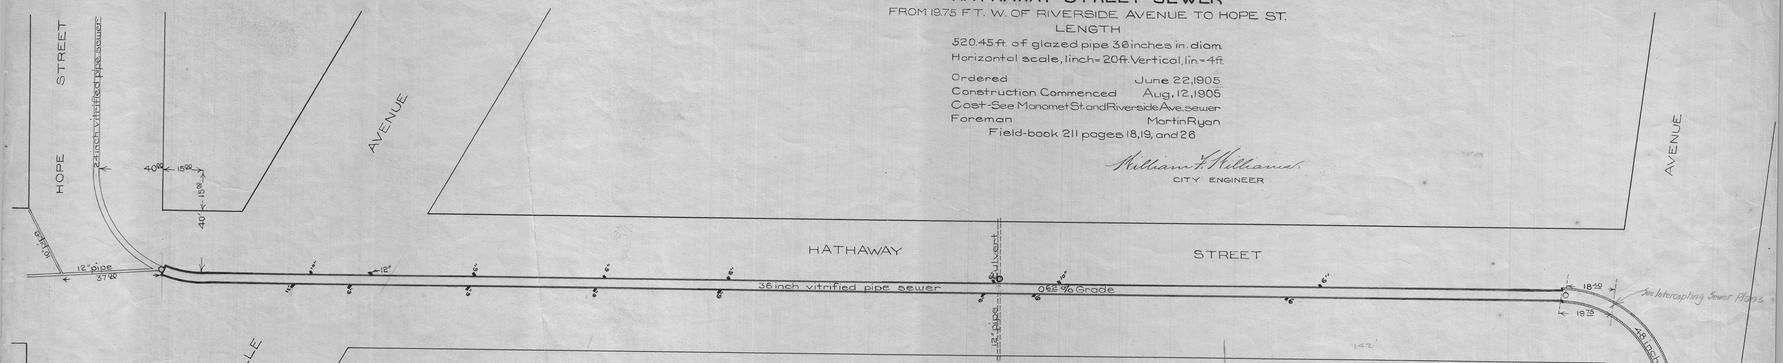

Cross Section
Scale, 1 inch = 4 feet



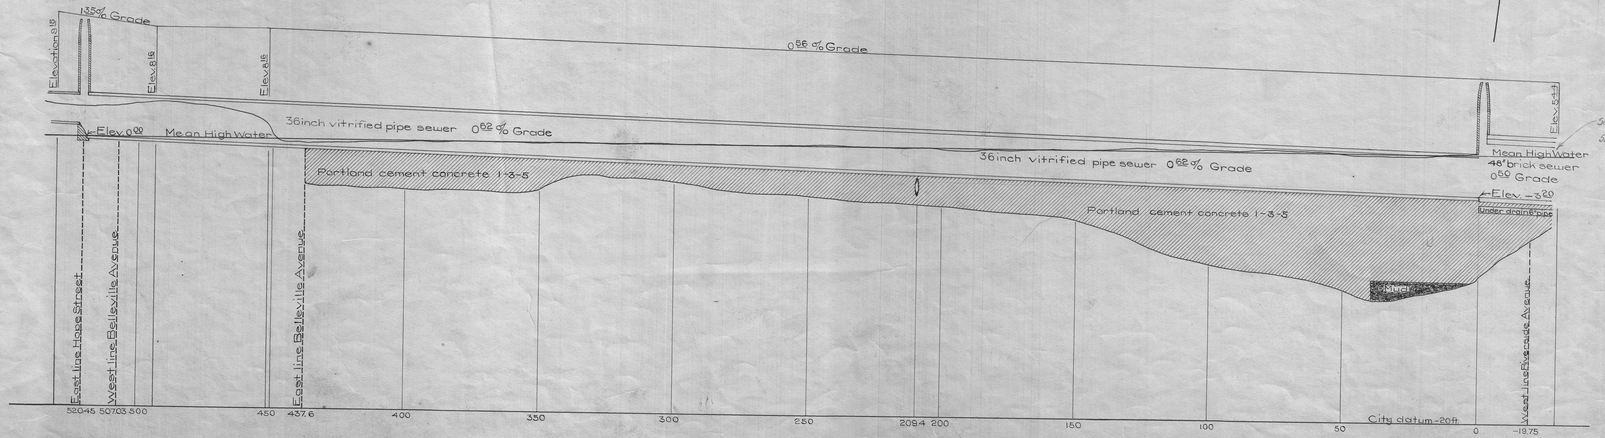

1922